

SMITH  
R 59  
2/19/79

MISSISSIPPI  
BOARD OF WATER COMMISSIONERS  
416 North State Street  
Jackson, Mississippi 39201

CODED

WATER WELL DRILLERS LOG

2-19-79 Griner Drilling Smith  
date well completed firm name county well located

LANDOWNER:  
Chesley Druet  
P.O. Box 324  
Laurel, MS 39440  
(mailing address)

description of formations encountered	from	to
Clay	0	30
SAND	30	147
streaked	147	273
SAND	273	294
streaked	294	315

WELL LOCATION: 1640'S + 1945'E  
sec. 26 T-10 R-14  
1/2 mi. near Summer Land  
(distance) (direction) (nearest town)

WELL PURPOSE: oil field  
(home, irrigation, municipal, industrial)

WELL COMPLETION DATA:

(1) diameter (inches) 4"  
(2) total depth (feet) 315'  
(3) static water level (feet) 38' below top of ground  
(4) casing steel 147'  
(material) (depth)  
3" if telescope see back.  
(size)  
(5) screen 42' 105'  
(length) (depth to top)  
3" perforated  
(size) (material)  
(6) pump 60  
(HP) (yield gpm)  
AC  
(type power)  
(7) electric log  
(yes or no)  
(organization running log)

(8) how well bottom plugged  
peel ORANGE

DRILLERS REMARKS:


Miss. Board of Water Comm.

FEB 26 1979

RECEIVED

If well telescopes please sketch and show depths.

GROUND LEVEL

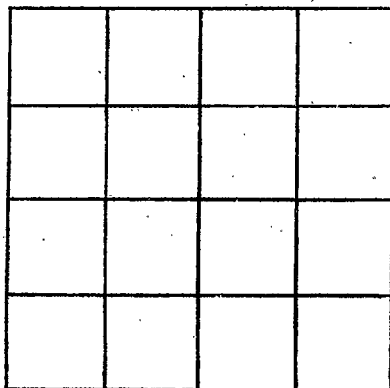

SECTION \_\_\_\_\_

Please indicate well location X.

ADDITIONAL INFORMATION

If more than one screen, show locations of each on sketch.