

SMITH
R 60
2116179

MISSISSIPPI
BOARD OF WATER COMMISSIONERS
416 North State Street
Jackson, Mississippi 39201

CODED

WATER WELL DRILLERS LOG

2-16-79 Griner Drilling Smith

date well completed

firm name

county well located

LANDOWNER:

Chesley Pruet
P.O. Box 324
Laurel, MS 39440
(mailing address)

description of formations encountered

from

to

Clay

0 30

Sand

30 147

WELL LOCATION: 1640' S 1945' E

sec. 26 T 10 N R 14 E OF

Hwy 28 Summer Land cor

(distance) (direction) (nearest town)

CODED

WELL PURPOSE:

(home, irrigation, municipal, industrial)

WELL COMPLETION DATA:

- (1) diameter (inches) 4"
- (2) total depth (feet) 189'
- (3) static water level (feet) 38' ^{below} above top of ground.
- (4) casing steel 147' (material) (depth)
- 3" (size) if telescope see back.
- (5) screen 21 126' (length) (depth to top)
- 3" perforated (size) (material)
- (6) pump — 65 (HP) (yield gpm)
- AC (type power)
- (7) electric log — (yes or no)

(organization running log)

(8) how well bottom plugged ORANGE

Miss. Board of Water Comm.


FEB 26 1979

DRILLERS REMARKS:

RECEIVED

If well telescopes please sketch and show depths.

GROUND LEVEL

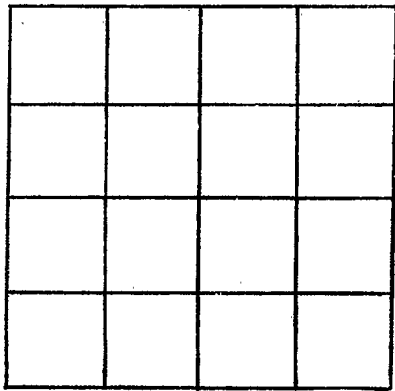

SECTION _____

Please indicate well location X.

ADDITIONAL INFORMATION

A series of horizontal lines for recording additional information, starting below the 'ADDITIONAL INFORMATION' header and extending to the bottom of the page.

If more than one screen, show locations of each on sketch.