

MISSISSIPPI DEPARTMENT OF NATURAL RESOURCES

Bureau of Land and Water Resources

Southport Mall


P.O. Box 10631

Jackson, Mississippi 39209

WATER WELL DRILLERS LOG

CODED

Griner Drilling Service, Inc.

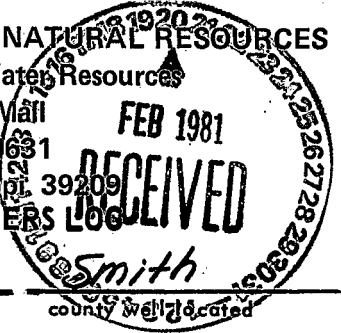

SMITH
R 61
2/4/81

date well completed

firm name

county well located

LANDOWNER:

Helmerich & Payne

Jackson, MS 39201

(mailing address)

description of formations encountered

from

to

clay, sand

0 250

clay, rock

250 273

clay, sand

273 336

sand

336 378

clay, sand

378 399

WELL LOCATION: 1900 S + 500 W of

No. 1 sec. 18 T. 10 N. R. 14 E. of Hester Taylorville

(distance) (direction) (nearest town)

WELL PURPOSE: oil field supply (home, irrigation, municipal, industrial)

WELL COMPLETION DATA:

(1) diameter (inches) ~~2 3/4~~ 3"

(2) total depth (feet) 399'

(3) static water level (feet) 75' below top of ground

(4) casing steel, 385' (material) (depth)

3" (size) if telescope see back.

(5) screen 42' 343' (length) (depth to top)

3" perforated (size) (material)

(6) pump - 80 (HP) (yield gpm)

AC (type power)

(7) electric log (yes or no)

(organization running log)

(8) how well bottom plugged Orange

peel

DRILLERS REMARKS:


DEPT. OF NATURAL RESOURCES BUREAU OF LAND & WATER RESOURCES

FEB 20 1981

RECEIVED

If well telescopes please
sketch and show depths.

GROUND LEVEL

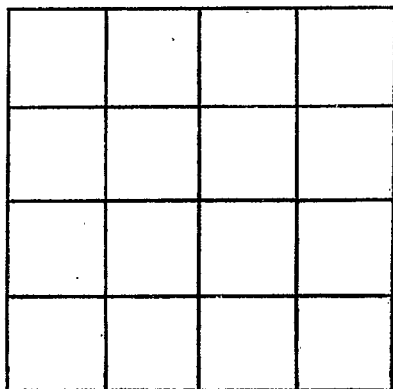

SECTION _____

Please indicate well location X.

ADDITIONAL INFORMATION

If more than one screen,
show locations of each on sketch.