

MISSISSIPPI DEPARTMENT OF NATURAL RESOURCES

Bureau of Land and Water Resources

Southport Mall

P.O. Box 10631

Jackson, Mississippi 39209

WATER WELL DRILLERS LOG

TOM GRIFFITH

DRILLING & WELL SERVICE, INC.

firm name

county well located

SMITH
R 62
6/29/82

2720⁰⁰
C

OK
7/19

6/29
date well completed

19

Smith
county well located

LANDOWNER:
New & Hughes Drilling Co -
P.O. Box 1487
Natchez, Miss.
(mailing address)

description of formations encountered

from

to

WELL LOCATION:
sec. 26 T. 10N S R. 14 E W
4 miles E of Indianville
(distance) (direction) (nearest town)

Sand & GRAVEL	0	140
Chalk & ROCKS	140	217
Sand	217	230
Stratified Sand	230	280
Sand	280	322
Chalk	322	350
Sand	350	490

WELL PURPOSE:
(home, irrigation, municipal, industrial)

WELL COMPLETION DATA:
(1) diameter (inches) 3"
(2) total depth (feet) 480
(3) static water level (feet) 150 below top of ground
(4) casing Steel 480
(material) (depth)
2 1/2" if telescope see back.
(size)
(5) screen 40' Steel
(length) (depth to top)
3" (size) (material)
(6) pump None 75
(HP) (yield gpm)
air lift
(type power)
(7) electric log Electric None
(yes or no)

Elevation: 338

2148220892232

(organization running log)

(8) how well bottom plugged B.W. Valve

DEPT. OF NATURAL RESOURCES
BUREAU OF LAND & WATER RESOURCES


DRILLERS REMARKS:

AUG - 9 1982

RECEIVED

If well telescopes please sketch and show depths.

GROUND LEVEL

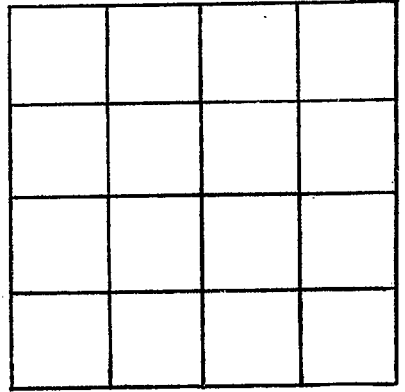

SECTION _____

Please indicate well location X.

ADDITIONAL INFORMATION

If more than one screen, show locations of each on sketch.