

MISSISSIPPI DEPARTMENT OF NATURAL RESOURCES

Bureau of Land and Water Resources

Southport Mall

P.O. Box 10631

Jackson, Mississippi 39209

WATER WELL DRILLERS LOG

Griner Drilling Service, Inc.

SMTH

R64 R63  
Smith  
3-25-84

CODED

date well completed

firm name

county well located

LANDOWNER:

Transcontinental Drilling  
1700 Capital Towers  
Jackson, Ms. 39201-3383  
(mailing address)

description of formations encountered

from

to

clay, sand	0	21
streaked clay, sand	21	168
sand	168	231
sand, clay	231	252
chalk	252	336
sand	336	357
chalk	357	546
chalk, shell	546	609
chalk	609	903

WELL LOCATION: 2072'S + 2003'E

sec. 24 T. 10 R. 14 E of No. 1 Edenton Summerland  
(distance) miles (direction) of (nearest town)

WELL PURPOSE: oilfield supply  
(home, irrigation, municipal, industrial)

WELL COMPLETION DATA:

- (1) diameter (inches) 3"
- (2) total depth (feet) 903'
- (3) static water level (feet) 70' below above top of ground.
- (4) casing Steel, 378'  
(material) (depth)  
3" If telescope see back.  
(size)
- (5) screen 42', 336'  
(length) (depth to top)  
3" perforated  
(size) (material)
- (6) pump 60  
(HP) (yield gpm)  
AC  
(type power)
- (7) electric log yes  
(yes or no)  
Bureau of Geology  
(organization running log)
- (8) how well bottom plugged orange peel

DEPT. OF NATURAL RESOURCES  
BUREAU OF LAND & WATER RESOURCES

MAR 29 1984


RECEIVED

DRILLERS REMARKS:

Well made 210' of sand

If well telescopes please sketch and show depths.

GROUND LEVEL

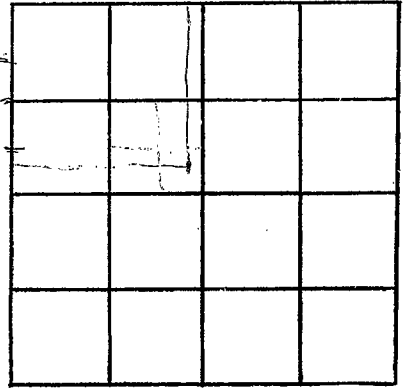

SECTION \_\_\_\_\_

Please indicate well location X.

ADDITIONAL INFORMATION

If more than one screen,  
show locations of each on sketch.

2646  
1322  
1323  
1370  
5235  
263