

Smith  
R 64  
7/24

MISSISSIPPI  
BOARD OF WATER COMMISSIONERS  
416 North State Street  
Jackson, Mississippi 39201

CODED

WATER WELL DRILLERS LOG

July 24 1984 Roy K. West Doby Smith  
date well completed firm name county well located

LANDOWNER:	description of formations encountered	from	to
JAMES Ford TAYLORSVILLE (mailing address)		top soil CLAY SAND CLAY SAND CLAY SAND	0 14 78 81 130 132
WELL LOCATION: sec. 18 T. 14N S. R. 13E (W) 4 miles E of TAYLORSVILLE (distance) (direction) (nearest town)			
WELL PURPOSE: (home, irrigation, municipal, industrial)			
WELL COMPLETION DATA:			
(1) diameter (inches) 4 1/2			
(2) total depth (feet) 152'			
(3) static water level (feet) 60' below top of ground.			
(4) casing PVC, 132' (material) (depth)			
(size) If telescope see back.			
(5) screen 20' 132' (length) (depth to top)			
44" PVC (size) (material)			
(6) pump 5 65 (HP) (yield gpm)			
REA (type power)			
(7) electric log NO (yes or no)			
(organization running log)			
(8) how well bottom plugged WASH VALVE			

CODED

DEPT. OF NATURAL RESOURCES  
BUREAU OF LAND & WATER RESOURCES


AUG 3 1984

RECEIVED

DRILLERS REMARKS:

If well telescopes please sketch and show depths.

GROUND LEVEL

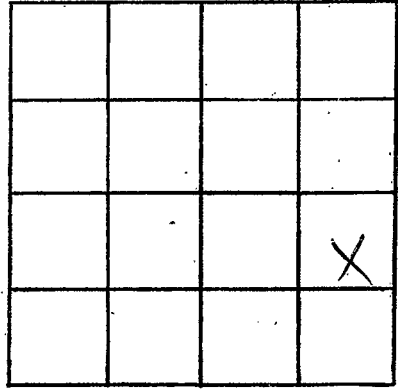

SECTION 18

Please indicate well location X.

ADDITIONAL INFORMATION

If more than one screen,  
show locations of each on sketch.