

MISSISSIPPI DEPARTMENT OF NATURAL RESOURCES

Bureau of Land and Water Resources

Southport Mall

P.O. Box 10631

CODED

Jackson, Mississippi 39209

WATER WELL DRILLERS LOG

Griner Drilling Service, Inc.

SMITH

R 6.5
Smith Co.
2-4-85

2-4-85 date well completed

Griner Drilling Service, Inc. firm name

SMITH county well located

LANDOWNER:

Endrey Exploration
L.V. 49 One Lincoln Ctr.
5400 LBJ Freeway
Dallas, TEXAS 75240
(mailing address)

description of formations encountered

from

to

clay

0

21

streaked

21

42

WELL LOCATION: 2311' N + 100' W
sec. 23 T 10 S R 14 E of
No. 1 Summerland

sand & p. gravel

42

210

clay

210

368

sand

368

460

clay

460

462

WELL PURPOSE: oilfield supply
(home, irrigation, municipal, industrial)


WELL COMPLETION DATA:

- (1) diameter (inches) 3"
- (2) total depth (feet) 462'
- (3) static water level (feet) 80' below above top of ground.
- (4) casing steel 462'
(material) (depth)
3"
(size) if telescope see back.
- (5) screen 42' 420'
(length) (depth to top)
3" perforated
(size) (material)
- (6) pump — 75
(HP) (yield gpm)
AC
(type power)
- (7) electric log (yes or no)

(organization running log)

(8) how well bottom plugged orange peel


DRILLERS REMARKS:

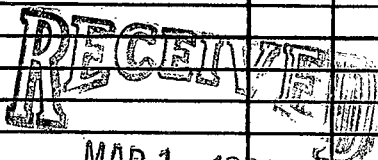

Department of Natural Resources
Bureau of Land & Water Resources

If well telescopes please
sketch and show depths.

GROUND LEVEL

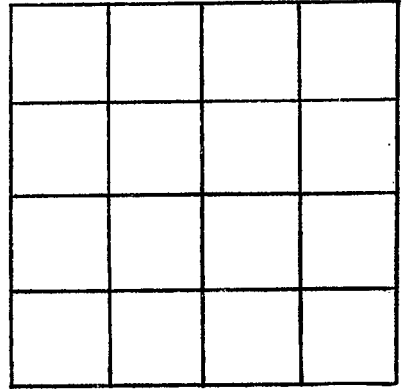

SECTION _____

Please indicate well location X.

ADDITIONAL INFORMATION

If more than one screen,
show locations of each on sketch.