

MISSISSIPPI DEPARTMENT OF NATURAL RESOURCES

Bureau of Land and Water Resources

Southport Mall

P.O. Box 10631

Jackson, Mississippi 39209

WATER WELL DRILLERS LOG

CODED

SMITH
R 66

July 18 1985 Royl West Drilling Smith
date well completed firm name county well located

LANDOWNER:
Tommy Sims
Rt 2 Taylorsville
(mailing address)

WELL LOCATION:
sec. 19 T. 10 N. R. 13 E
S W
5 miles E of Taylorsville
(distance) (direction) (nearest town)

WELL PURPOSE:
(home, irrigation, municipal, industrial)

WELL COMPLETION DATA:

(1) diameter (inches) 4"

(2) total depth (feet) 170'

(3) static water level (feet) 62' below above top of ground.

(4) casing PVC 160'
(material) (depth)
(size) If telescope see back.

(5) screen 20' 160'
(length) (depth to top)
4" PVC
(size) (material)

(6) pump 1 30
(HP) (yield gpm)
REA
(type power)

(7) electric log AB
(yes or no)
(organization running log)

(8) how well bottom plugged
WASH CEMENT

description of formations encountered	from	to
CLAY	0	6
SAND	6	42
CLAY	42	65
SAND	65	70
CLAY	70	98
SAND	98	114
CLAY	114	145
SAND	145	170


RECEIVED
AUG 11 1985

Department of Natural Resources
Bureau of Land & Water Resources

DRILLERS REMARKS:

If well telescopes please
sketch and show depths.

GROUND LEVEL

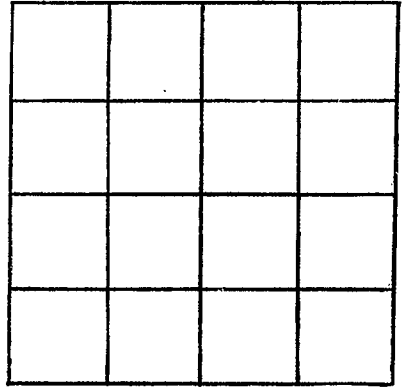

SECTION _____

Please indicate well location X.

ADDITIONAL INFORMATION

If more than one screen,
show locations of each on sketch.