

Smith
 R200 CODED
 2-67

MISSISSIPPI
 BOARD OF WATER COMMISSIONERS
 416 North State Street
 Jackson, Mississippi 39201

WATER WELL DRILLERS LOG

2-27 date well completed 1967 W. K. Banner Water Well Smith firm name county well located

LANDOWNER: Mack M. Kenley
 Route 3
 Bay Springs Miss.
 (mailing address)

| description of formations encountered | from | to |
|---------------------------------------|------|-----|
| Red Clay | 0. | 15 |
| Red Sand | 15. | 100 |
| Yellow Clay | 60. | 90 |
| Fin Sand | 90. | 130 |

WELL LOCATION:
 sec. 4 T10 N S R14 E W
 miles _____ of _____
 (distance) (direction) (nearest town)

WELL PURPOSE: Home
 (home, irrigation, municipal, industrial)

WELL COMPLETION DATA:

(1) diameter (inches) 2"
 (2) total depth (feet) 130 ft
 (3) static water level (feet) 70 below above top of ground.
 (4) casing Galv. 12 ft. (material) (depth)
 2" (size) If telescope see back.
 (5) screen 4' (length) 130 (depth to top)
 2" (size) SS (material)
 (6) pump 1 1/2 (HP) 10 (yield gpm)
 Elec- (type power)
 (7) electric log no (yes or no)
 (organization running log)
 (8) how well bottom plugged Wash Well

CODED

JUN 27 1968
 MISS. BOARD OF
 WATER COMM.


DRILLERS REMARKS:

If well telescopes please sketch and show depths.

GROUND LEVEL

130 ft 2"

4' SS 2"

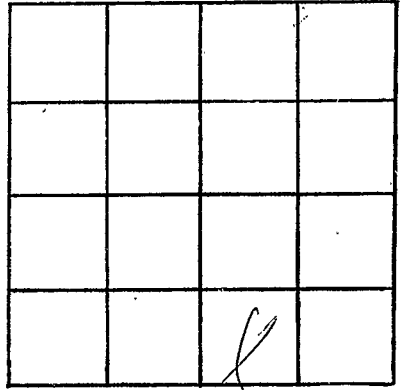

SECTION 4

Please indicate well location X.

ADDITIONAL INFORMATION

If more than one screen, show locations of each on sketch.