

SMITH
R 2002
5-19-76

MISSISSIPPI
 BOARD OF WATER COMMISSIONERS
 416 North State Street
 Jackson, Mississippi 39201

13¢

WATER WELL DRILLERS LOG


May 19 1976 Wick-Barnes Water Well Smith
 date well completed firm name county well located

LANDOWNER: <u>Charles Pickering</u>	description of formations encountered	from	to
<u>At. 1 Taylorsville Miss.</u> (mailing address)	<u>Red Clay Course Sand and Gravel</u>	<u>0</u>	<u>8</u> <u>36</u>
WELL LOCATION: sec. <u>20 T 10 N 14 E</u> <u>3 1/2</u> miles <u>S</u> of <u>Taylorsville</u> (distance) (direction) (nearest town)			
WELL PURPOSE: <u>Home</u> (home, irrigation, municipal, industrial)			
WELL COMPLETION DATA: (1) diameter (inches) <u>2</u> (2) total depth (feet) <u>31</u> (3) static water level (feet) <u>15</u> below top of ground. (4) casing <u>Plastic</u> , <u>27</u> (material) (depth) <u>2"</u> (size) if telescope see back. (5) screen <u>4</u> (length) (depth to top) <u>0.8</u> , <u>Stainless S.</u> (size) (material) (6) pump <u>3hp</u> <u>10</u> (HP) (yield gpm) <u>Electric</u> (type power) (7) electric log <u>NO</u> (yes or no) (organization running log) (8) how well bottom plugged <u>wash where</u>			
DRILLERS REMARKS:			

MISSISSIPPI BOARD OF WATER COMMISSIONERS

If well telescopes please sketch and show depths.

GROUND LEVEL

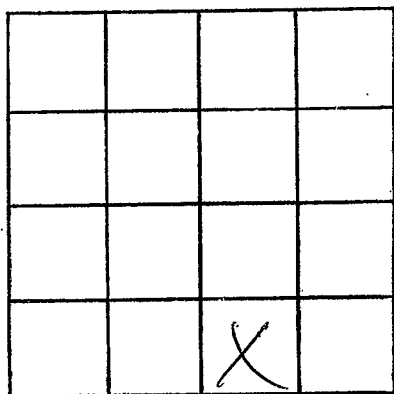

SECTION 20

Please indicate well location X.

ADDITIONAL INFORMATION

If more than one screen,
show locations of each on sketch.