

Sec 18 in this T&R is in Smith Co due East of Taylorsville.

SMITH
R 2003
8-5-76

MISSISSIPPI
BOARD OF WATER COMMISSIONERS
416 North State Street
13¢ Jackson, Mississippi 39201

WATER WELL DRILLERS LOG

Smith

8-5-76 19. W.K. Barnes Water Wells, Inc. firm name
date well completed county well located

LANDOWNER: <u>Oliver Parker</u> <u>Rt. 2 Taylorsville, Miss</u> (mailing address)	description of formations encountered	from	to
		<u>Red Clay</u>	<u>0</u>
	<u>Red Sand</u>	<u>12</u>	<u>40</u>
	<u>White Sand</u>	<u>40</u>	<u>74</u>

WELL LOCATION:
sec. 10 T. 10 S. R. 13 E. W. 7
7 miles North of Taylorsville
(distance) (direction) (nearest town)

WELL PURPOSE: Home use
(home, irrigation, municipal, industrial)

- WELL COMPLETION DATA:
- (1) diameter (inches) 2
 - (2) total depth (feet) 74
 - (3) static water level (feet) 60 below top of ground. above
 - (4) casing Galv. 70 ft.
(material) (depth)
 - 2" If telescope see back.
(size)
 - (5) screen 4 ft.
(length) (depth to top)
 - 2" Stamless S-06 Sheet
(size) (material)
 - (6) pump Roll 24
(HP) (yield gpm)
 - Electric
(type power)
 - (7) electric log NO
(yes or no)
 - (organization running log)
 - (8) how well bottom plugged check water

DRILLERS REMARKS:
The Next 20' on Pump
See Hand

RECEIVED


APR 4 1976

MISS. Bd. OF WATER COMMISSIONERS

RECEIVED

If well telescopes please sketch and show depths.

GROUND LEVEL

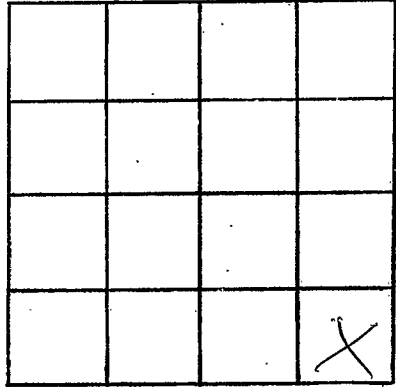

SECTION 18

Please indicate well location X.

ADDITIONAL INFORMATION

A series of horizontal lines for writing additional information.

If more than one screen, show locations of each on sketch.