

SMITH  
R 2005  
55-81

MISSISSIPPI  
BOARD OF WATER COMMISSIONERS  
416 North State Street  
Jackson, Mississippi 39201

WATER WELL DRILLERS LOG

May 5 1981 Roy V West Delg Smith  
date well completed firm name county well located

LANDOWNER: ALLEN ULLEN DORF  
SUMMER LAND  
(mailing address)

description of formations encountered	from	to
CLAY	0	70
SAND	70	140

WELL LOCATION:  
sec. 18 T-10 N R-13 E  
S W  
8 miles E of Taylorsville  
(distance) (direction) (nearest town)

WELL PURPOSE: HOME  
(home, irrigation, municipal, industrial)


- WELL COMPLETION DATA:
- (1) diameter (inches) 4"
  - (2) total depth (feet) 140'
  - (3) static water level (feet) 50' below top of ground.
  - (4) casing PVC, 130'  
(material) (depth)
  - (size) if telescope see back.
  - (5) screen 10', 130'  
(length) (depth to top)
  - 4" PVC  
(size) (material)
  - (6) pump 3/4, 18  
(HP) (yield gpm)
  - REA  
(type power)
  - (7) electric log NO  
(yes or no)
  - (organization running log)
  - (8) how well bottom plugged  
WASH VALVE

DRILLERS REMARKS:

DEPT. OF NATURAL RESOURCES  
BUREAU OF LAND & WATER RESOURCES  
JUN 17 1981  
RECEIVED

If well telescopes please sketch and show depths.

GROUND LEVEL

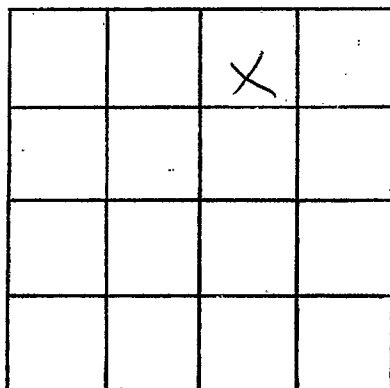

SECTION 18

Please indicate well location X.

ADDITIONAL INFORMATION

If more than one screen,  
show locations of each on sketch.