

SMITH
 R 2000
 5-22-81

MISSISSIPPI
 BOARD OF WATER COMMISSIONERS
 416 North State Street
 Jackson, Mississippi 39201

WATER WELL DRILLERS LOG

May 22 1981 Roy H. West Drig Smith
 date well completed firm name county well located

LANDOWNER: OREE Duckworth
 TAYLORSVILLE
 (mailing address)

description of formations encountered	from	to
CLAY	0	51
SAND	51	87

WELL LOCATION:
 sec. 23 T 10 N R 14 E
 S W
 2 miles E of TAYLORSVILLE
 (distance) (direction) (nearest town)

WELL PURPOSE:
 (home, irrigation, municipal, industrial)

- WELL COMPLETION DATA:
- (1) diameter (inches) 2"
 - (2) total depth (feet) 87'
 - (3) static water level (feet) 30' below top of ground.
 - (4) casing PVC 81' (material) (depth)
 - (size) if telescope see back.
 - (5) screen 6' 81' (length) (depth to top)
 - 1 1/2" STAINLESS STEEL (size) (material)
 - (6) pump 1 (HP) 12 (yield gpm)
 - REA (type power)
 - (7) electric log NO (yes or no)
 - (organization running log)
 - (8) how well bottom plugged WASH VALUE


DRILLERS REMARKS:

DEPT. OF NATURAL RESOURCES
 BUREAU OF LAND & WATER RESOURCES

JUN 17 1981
 RECEIVED

If well telescopes please sketch and show depths.

GROUND LEVEL

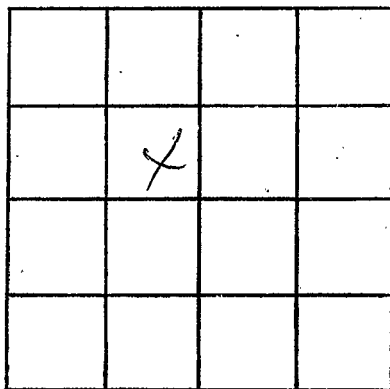

SECTION 23

Please indicate well location X.

ADDITIONAL INFORMATION

If more than one screen,
show locations of each on sketch.