

Smith  
R  
2007

MISSISSIPPI  
BOARD OF WATER COMMISSIONERS  
416 North State Street  
Jackson, Mississippi 39201

WATER WELL DRILLERS LOG

6-9 1982 Roy V. West Drlg Smith  
date well completed firm name county well located


LANDOWNER:	description of formations encountered	from	to
Tom Duckworth Rt 3 Box 201 Taylorsville (mailing address)			
<b>WELL LOCATION:</b>			
sec. 2 T 10 N S R 14 E W 5 miles WE of Taylorsville (distance) (direction) (nearest town)			
<b>WELL PURPOSE:</b> HOME (home, irrigation, municipal, industrial)			
<b>WELL COMPLETION DATA:</b>			
(1) diameter (inches) 2"			
(2) total depth (feet) 90'			
(3) static water level (feet) 52' below top of ground.			
(4) casing PVC, 85' (material) (depth)			
(size) If telescope see back.			
(5) screen 5', 85' (length) (depth to top)			
2", PVC (size) (material)			
(6) pump 1, 10 (HP) (yield gpm)			
REA (type power)			
(7) electric log NO (yes or no)			
(organization running log)			
(8) how well bottom plugged WASH VALVE			
DRILLERS REMARKS:			

DEPT. OF NATURAL RESOURCES  
BUREAU OF LAND & WATER RESOURCES

JUL 19 1982  
RECEIVED

If well telescopes please sketch and show depths.

GROUND LEVEL

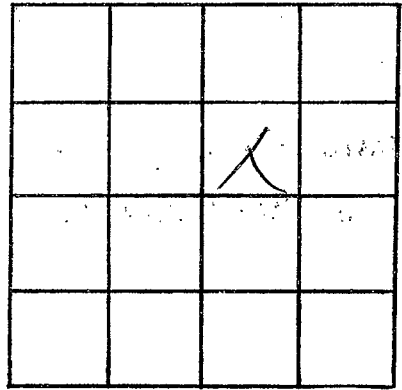

SECTION 2

Please indicate well location X.

ADDITIONAL INFORMATION

If more than one screen, show locations of each on sketch.