

Smith  
R 2009

MISSISSIPPI  
 BOARD OF WATER COMMISSIONERS  
 416 North State Street  
 Jackson, Mississippi 39201

WATER WELL DRILLERS LOG

4-24 1984 ROY WILKINSON DR/G Smith  
 date well completed firm name county well located

LANDOWNER:	description of formations encountered	from	to
<u>JAMES Ford</u>	<u>topsoil</u>	<u>0</u>	<u>2</u>
<u>TAYLORSVILLE MS</u> (mailing address)	<u>CLAY</u>	<u>2</u>	<u>14</u>
	<u>SAND</u>	<u>14</u>	<u>190'</u>
<b>WELL LOCATION:</b>			
sec. <u>18</u> T. <u>10</u> N. R. <u>13</u> E. S. <u>5</u> W.			
<u>4</u> miles <u>E</u> of <u>TAYLORSVILLE</u> (distance) (direction) (nearest town)			
<b>WELL PURPOSE:</b> (home, irrigation, municipal, industrial)			
<b>WELL COMPLETION DATA:</b>			
(1) diameter (inches) <u>4"</u>			
(2) total depth (feet) <u>190'</u>			
(3) static water level (feet) <u>115'</u> <u>Pvc</u> below above top of ground.			
(4) casing <u>4"</u> (material) <u>Pvc</u> (depth) <u>120'</u>			
<u>4"</u> (size) If telescope see back.			
(5) screen <u>20'</u> (length) <u>170'</u> (depth to top)			
<u>4"</u> (size) <u>Pvc</u> (material)			
(6) pump <u>S</u> (HP) <u>75</u> (yield gpm)			
<u>REA</u> (type power)			
(7) electric log <u>NO</u> (yes or no)			
<u>(organization running log)</u>			
(8) how well bottom plugged <u>WASH VALVE</u>			
DRILLERS REMARKS:			


DEPT. OF NATURAL RESOURCES  
 BUREAU OF LAND & WATER RESOURCES

MAY - 4 1984

RECEIVED

If well telescopes please sketch and show depths.

GROUND LEVEL

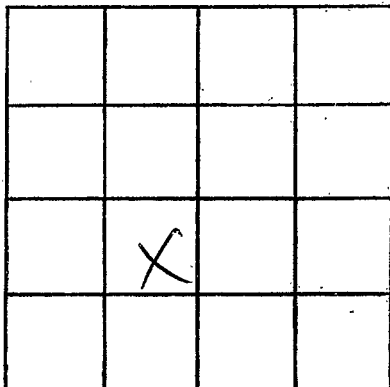

SECTION 18

Please indicate well location X.

ADDITIONAL INFORMATION

If more than one screen,  
show locations of each on sketch.