

MISSISSIPPI DEPARTMENT OF NATURAL RESOURCES

Bureau of Land and Water Resources

Southport Mall

P.O. Box 10631

Jackson, Mississippi 39209

WATER WELL DRILLERS LOG

Smith
R 2010

Oct 3

1984 Roy V. West Dalg

Smith

date well completed

firm name

county well located

LANDOWNER:
Soundra Boyd
TAYLORSVILLE MS
(mailing address)

description of formations encountered

from to

Topsoil	0	1
SAND	1	22
SOFT Limestone	22	105
CLAY	105	265
SAND	265	300

WELL LOCATION:

sec. 16 T. 10 N. R. 14 E
S W
1 miles E of TAYLORSVILLE
(distance) (direction) (nearest town)

WELL PURPOSE:

(home, irrigation, municipal, industrial)

WELL COMPLETION DATA:

- (1) diameter (inches) 2"
- (2) total depth (feet) 300'
- (3) static water level (feet) 16' below above top of ground.
- (4) casing PVC, 295'
(material) (depth)
2" if telescope see back.
(size)
- (5) screen 5', 295'
(length) (depth to top)
2", PVC
(size) (material)
- (6) pump 1, 8
(HP) (yield gpm)
REA
(type power)
- (7) electric log NO
(yes or no)
(organization running log)

(8) how well bottom plugged
WASH VALVE


DRILLERS REMARKS:

DEPT. OF NATURAL RESOURCES
BUREAU OF LAND & WATER RESOURCES

OCT 11 1984
RECEIVED

If well telescopes please sketch and show depths.

GROUND LEVEL

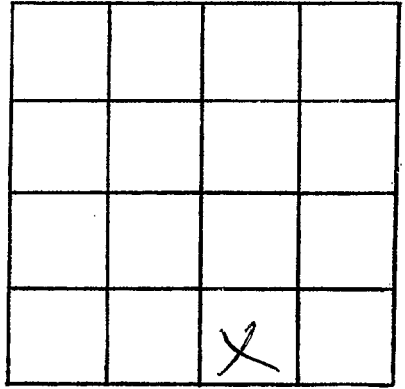

SECTION 16

Please indicate well location X.

ADDITIONAL INFORMATION

If more than one screen,
show locations of each on sketch.