

# MISSISSIPPI DEPARTMENT OF NATURAL RESOURCES

Bureau of Land and Water Resources

COUNTY WELL LOCATED <i>Smith</i>	
WELL NUMBER <i>R2001</i>	CODED
DATE WELL COMPLETED <i>10-19-88</i>	

*272 cord*

PERMIT NUMBER <i>0-407</i>
NAME OF DRILLING FIRM <i>Tom Griffith Water Well</i>
<i>Columbia, MS</i>

P.O. Box 10631  
Jackson, Mississippi 39209  
**WATER WELL DRILLERS LOG**

NAME & MAILING ADDRESS OF LANDOWNER <i>Energy Drilling</i>		
<i>P.O. Box 905</i>		
<i>Natchez, Ms 39120</i>		
WELL LOCATION: SEC	TOWNSHIP	RANGE
<i>35</i>	<i>10</i>	<i>14</i>
DISTANCE	DIRECTION	NEAREST TOWN
<i>2</i> Miles	<i>SE</i>	<del>of</del>
OTHER LANDMARK <i>Taylorville</i>		
WELL PURPOSE: Home, Irrigation, Municipal, Industrial, Fish Pond, etc. <i>Oil location Supply</i>		

<b>PUMP DATA</b>		
PUMP TYPE (Circle One): Submersible, Turbine, Jet, Flowing Well, Other (Describe) <i>air lift</i>		
POWER TYPE (Circle One): Electric, Tractor, Diesel, Gasoline, Butane, Other (Describe) _____		
Pump Capacity (GPM) <i>55</i>	No. of Stages	Setting Depth <i>175</i> FT.
PUMP TEST		
Well yielded _____ GPM with a drawdown of _____ ft. after _____ hours of pumping		

<b>WELL DATA</b>		
Well Depth <i>195</i>	Casing Diameter (In.) <i>4"</i>	Casing Length (Ft.) <i>160</i>
Type of Casing <i>PVC</i>	Hole Depth <i>195</i>	Depth to Static Water Level <i>95</i>
TYPE OF COMPLETION: (Circle One or More): <input checked="" type="checkbox"/> Gravel Packed, <input type="checkbox"/> Underreamed, <input type="checkbox"/> Telescoped, <input checked="" type="checkbox"/> Natural Development, <input type="checkbox"/> Open Hole, <input type="checkbox"/> Other (Describe) _____		
Top of Lap Pipe or Reduction in Casing  <b>FEET</b> IF TELESCOPED OR MORE THAN ONE SCREEN: USE BACK PAGE		

<b>LOG DATA</b>	
TYPE OF LOG RUN (Circle One): No Log Run, Electric, Gamma Ray, Density, Sonic, Neutron, Other (Describe) _____	
Name of Organization Running Log	

<b>SCREEN DATA</b>		
Diameter - Inches <i>4"</i>	Length - Feet <i>35</i>	Slot Size - Inches <i>.014</i>
Screen Type <i>PVC</i>	Depth to Bottom - Feet <i>195</i>	


<b>GEOLOGIC DATA (Office Use Only)</b>			
Surface Elev.	Geologic Unit	Unit Thickness	Depth to Top
Subs. SWL	Date	Analysis	Aquifer Test
Driller's Remarks			

DESCRIPTION OF FORMATIONS ENCOUNTERED	FROM	TO	FORMATIONS (Continued) FROM TO
<i>Sandy Clay</i>	<i>0</i>	<i>60</i>	<div style="font-size: 2em; font-weight: bold; opacity: 0.5;">RECEIVED</div> <div style="font-size: 1.5em; font-weight: bold; margin-top: 10px;">JUN 13 1989</div> <div style="font-weight: bold; margin-top: 10px;">Department of Natural Resources Bureau of Land &amp; Water Resources</div>
<i>Hard Clay</i>	<i>60</i>	<i>80</i>	
<i>Clay</i>	<i>80</i>	<i>100</i>	
<i>Finesand</i>	<i>100</i>	<i>120</i>	
<i>Sand</i>	<i>140</i>	<i>160</i>	
<i>Good sand</i>	<i>160</i>	<i>195</i>	

IF MORE SPACE IS NEEDED, USE BACK

If well telescopes please sketch and show depths.

GROUND LEVEL

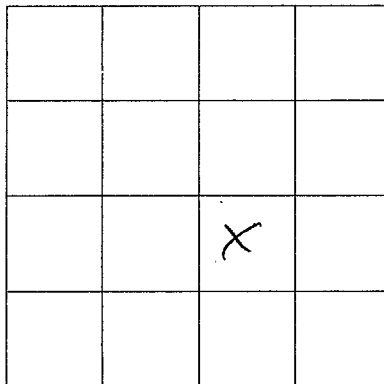

SECTION 35

Please indicate well location X.

ADDITIONAL INFORMATION

If more than one screen,  
show location of each on sketch.