

MISSISSIPPI DEPARTMENT OF ENVIRONMENTAL QUALITY
Bureau of Land and Water Resources

P. O. Box 10631
Jackson, MS 39289-0631
WATER WELL DRILLERS LOG

COUNTY WELL LOCATED SMITH	
WELL NUMBER R	CODED
DATE WELL COMPLETED 7-6-91	

PERMIT NUMBER
NAME OF DRILLING FIRM PARKER Well Service

NAME & MAILING ADDRESS OF LANDOWNER RON WHOBREY RT. 3 TAYLORSVILLE MS 39168		
WELL LOCATION: SEC	TOWNSHIP	RANGE
25	10	14
DISTANCE	DIRECTION	NEAREST TOWN
1/2 Miles	North of	Summerland
OTHER LANDMARK ON OLD TAYLORSVILLE ROAD		
WELL PURPOSE: Home, Irrigation, Municipal, Industrial, Fish Pond, etc. Chicken Houses		

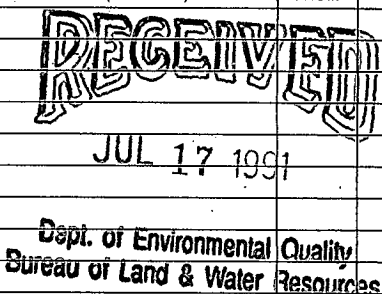
PUMP DATA		
PUMP TYPE (Circle One): <u>Submersible</u> , Turbine, Jet, Flowing Well, Other (Describe) _____		
POWER TYPE (Circle One): <u>Electric</u> , Tractor, Diesel, Gasoline, Butane, Other (Describe) _____ H/P <u>1</u>		
Pump Capacity (GPM)	No. of Stages	Setting Depth
20-30	10	75 FT.
PUMP TEST		
Well yielded 25 GPM with a drawdown of 40 ft. after 12 hours of pumping		

WELL DATA		
Well Depth 80	Casing Diameter (In.) 4"	Casing Length (Ft.) 70'
Type of Casing Pvc	Hole Depth 80'	Depth to Static Water Level 40'
TYPE OF COMPLETION: (Circle One or More): <u>Natural Development</u> , Gravel Packed, Underreamed, Telescoped, Open Hole, Other		
Top of Lap Pipe or Reduction in Casing FEET IF TELESKOPED OR MORE THAN ONE SCREEN: USE BACK PAGE		

LOG DATA	
TYPE OF LOG RUN (Circle One): No Log Run, Electric, Gamma Ray, Density, Sonic, Neutron, Other (Describe) _____	
Name of Organization Running Log	

SCREEN DATA		
Diameter - Inches 4"	Length - Feet 10'	Slot Size - Inches 0.10
Screen Type Pvc	Depth to Bottom - Feet 80'	

GEOLOGIC DATA (Office Use Only)			
Surface Elev.	Geologic Unit	Unit Thickness	Depth to Top
Subs. SWL	Date	Analysis	Aquifer Test
Driller's Remarks			

DESCRIPTION OF FORMATIONS ENCOUNTERED	FROM	TO	FORMATIONS (Continued)	FROM	TO
CLAY SAND	0	40			
	40	80			

IF MORE SPACE IS NEEDED, USE BACK

If well telescopes please sketch and show depths.

GROUND LEVEL

X			

SECTION 25

Please indicate well location X.

ADDITIONAL INFORMATION

If more than one screen,
show location of each on sketch.