

MISSISSIPPI DEPARTMENT OF ENVIRONMENTAL QUALITY

Office of Land and Water Resources

P. O. Box 10631
Jackson, MS 39289-0631
WATER WELL DRILLERS LOG

COUNTY WELL LOCATED SMITH	
WELL NUMBER R 2020	CODED
DATE WELL COMPLETED 3-16-00	

PERMIT NUMBER
NAME OF DRILLING FIRM PARKER WELL SERVICE

NAME & MAILING ADDRESS OF LANDOWNER TOMMY MOORE TAYLORSVILLE MS.		
WELL LOCATION: SEC 35 TOWNSHIP T10N RANGE R14E		
DISTANCE 3 Miles	DIRECTION EAST of	NEAREST TOWN T. VILLE
OTHER LANDMARK		
WELL PURPOSE: Home, Irrigation, Municipal, Industrial, Fish Pond, etc. HOUSE		

PUMP DATA		
PUMP TYPE (Circle One): <u>Submersible</u> , Turbine, Jet, Flowing Well, Other (Describe)		
POWER TYPE (Circle One): <u>Electric</u> , Tractor, Diesel, Gasoline, Butane, Other (Describe) H/P 1		
Pump Capacity (GPM) 20	No. of Stages 9	Setting Depth 80 FT.
PUMP TEST		
Well yielded 25 GPM with a drawdown of 10 ft. after 24 hours of pumping		

WELL DATA		
Well Depth 120	Casing Diameter (In.) 4"	Casing Length (Ft.) 100
Type of Casing PVC	Hole Depth 120	Depth to Static Water Level 40
TYPE OF COMPLETION: (Circle One or More): <u>Natural Development</u> , Gravel Packed, Underreamed, Telescoped, Open Hole, Other		
WELL GROUTED TO A DEPTH OF _____ FEET Type Grout (circle one): Cement, Bentonite, or Mix		

LOG DATA	
TYPE OF LOG RUN (Circle One): No Log Run, Electric, Gamma Ray, Density, Sonic, Neutron, Other (Describe)	
Name of Organization Running Log	

SCREEN DATA		
Diameter - Inches 4"	Length - Feet 10'	Slot Size - Inches 006
Screen Type PVC	Depth to Bottom - Feet 120'	


GEOLOGIC DATA (Office Use Only)			
Surface Elev.	Geologic Unit	Unit Thickness	Depth to Top
Subs. SWL	Date	Analysis	Aquifer Test
Driller's Remarks COARSE SAND Good well			
Top of Lap Pipe or Reduction in Casing			
FEET		IF TELESCOPED OR MORE THAN ONE SCREEN: USE BACK PAGE	

DESCRIPTION OF FORMATIONS ENCOUNTERED	FROM	TO
CLAY & SAND	0	20
	20	120

FORMATIONS (Continued)	FROM	TO
RECEIVED		
MAR 22 2000		
Dept. of Environmental Quality Office of Land & Water Resources		
IF MORE SPACE IS NEEDED, USE BACK		

If well telescopes please
sketch and show depths.

GROUND LEVEL

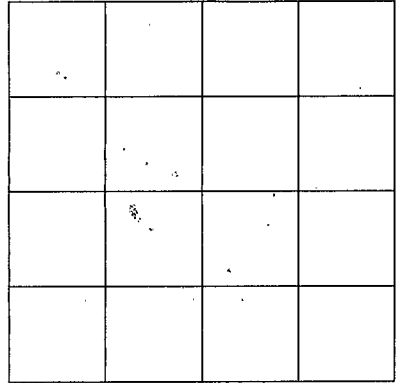

SECTION 35

Please indicate well location X.

ADDITIONAL INFORMATION

GO 28 EAST OF
T. VILLE OF 28 Hk.

If more than one screen,
show location of each on sketch.