

MISSISSIPPI DEPARTMENT OF ENVIRONMENTAL QUALITY
Office of Land and Water Resources

P. O. Box 10631
Jackson, MS 39289-0631
WATER WELL DRILLERS LOG

COUNTY WELL LOCATED
SMITH

WELL NUMBER
R-2023

DATE WELL COMPLETED
10-26-01

PERMIT NUMBER

NAME OF DRILLING FIRM
Parker well Service

NAME & MAILING ADDRESS OF LANDOWNER
**HILTON KING
STRINGER MS.**

WELL LOCATION: SEC **17** TOWNSHIP **10** RANGE **14**

DISTANCE **12** Miles **EAST** of **TAYLORSVILLE**

OTHER LANDMARK
**SUMMERLAND MS.
CAMP HOUSE POND**

WELL PURPOSE: Home, Irrigation, Municipal, Industrial, Fish Pond, etc.
CAMP HOUSE POND

PUMP DATA

PUMP TYPE (Circle One):
Submersible, Turbine, Jet, Flowing Well,
Other (Describe)

POWER TYPE (Circle One):
Electric, Tractor, Diesel, Gasoline, Butane,
Other (Describe) H/P **1**

Pump Capacity (GPM) **20** No. of Stages **9** Setting Depth **90'** FT.

PUMP TEST
Well yielded **25** GPM with
a drawdown of **10'** ft.
after **24** hours of pumping

WELL DATA

Well Depth 105	Casing Diameter (In.) 4"	Casing Length (Ft.) 95'
Type of Casing PVC	Hole Depth 105	Depth to Static Water Level 20'

TYPE OF COMPLETION: (Circle One or More):
Natural Development, Gravel Packed, Underreamed, Telescoped,
Open Hole, Other

WELL GROUTED TO A DEPTH OF **6** FEET
Type Grout (circle one): Cement, Bentonite, or Mix

LOG DATA

TYPE OF LOG RUN (Circle One):
No Log Run, Electric, Gamma Ray, Density, Sonic, Neutron,
Other (Describe)

Name of Organization Running Log

SCREEN DATA

Diameter - Inches 4"	Length - Feet 10'	Slot Size - Inches 008
Screen Type PVC	Depth to Bottom - Feet 105	

GEOLOGIC DATA (Office Use Only)

Surface Elev.	Geologic Unit	Unit Thickness	Depth to Top
Subs. SWL	Date	Analysis	Aquifer Test

Driller's Remarks
**COURSE SAND ALL
THE WAY DOWN**

Top of Lap Pipe or Reduction in Casing

FEET IF TELESCOPED OR MORE THAN ONE SCREEN: USE BACK PAGE


DESCRIPTION OF FORMATIONS ENCOUNTERED	FROM	TO
CLAY SAND	0	10
	10	105

FORMATIONS (Continued)	FROM	TO
REC'D NOV 02 2001		

IF MORE SPACE IS NEEDED, USE BACK

If well telescopes please
sketch and show depths.

GROUND LEVEL

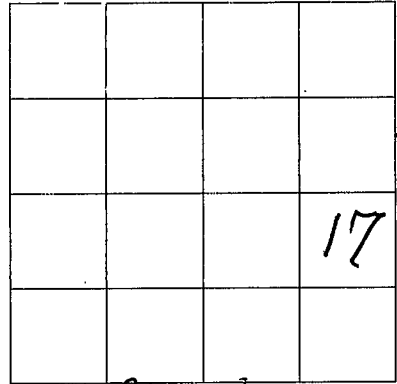

RIHW

SECTION 17

Please indicate well location X.

ADDITIONAL INFORMATION

GO TO SUMMERLAND
ON HWY 28 EAST.
TAKE LEFT GO 6 Mi.
NORTH ON HWY-8
TO 2ND. LEFT TAKE
GO 1 BLOCK. TAKE
LEFT ON DIRT
ROAD WELL ON
LEFT

If more than one screen,
show location of each on sketch.