

CODED

MISSISSIPPI  
BOARD OF WATER COMMISSIONERS  
416 North State Street  
Jackson, Mississippi 39201

WATER WELL DRILLERS LOG

Stone  
A3  
2-67

2-23 1947 Lewis Smith Stone  
date well completed firm name county well located

LANDOWNER:

Hiland Seal  
Wiggins Miss  
(mailing address)

description of formations encountered

	from	to
Top Soil	0	2
Clay	2	14
Sand	14	52
Sand Gravel	52	60


WELL LOCATION:

sec. 19 T. 2 N. R. 13 E.  
12 miles West of Wiggins  
(distance) (direction) (nearest town)

WELL PURPOSE: Home  
(home, irrigation, municipal, industrial)

WELL COMPLETION DATA:

- (1) diameter (inches) 2"
- (2) total depth (feet) 60'
- (3) static water level (feet) 30 below top of ground.
- (4) casing Plastic (material), (depth) (size) If telescope see back.
- (5) screen 5' (length), (depth to top) 2" (size), (material)
- (6) pump (HP) (yield gpm) (type power)
- (7) electric log no (yes or no) (organization running log)
- (8) how well bottom plugged

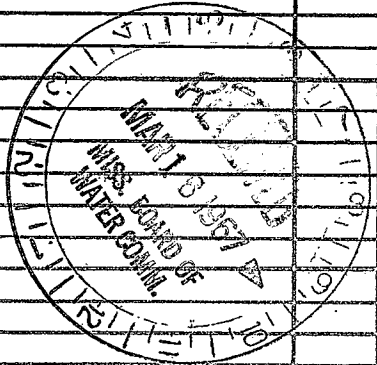

DRILLERS REMARKS: Building location Pump to be installed when haul is completed.

If well telescopes please sketch and show depths.

GROUND LEVEL

X			

SECTION 19

Please indicate well location X.

ADDITIONAL INFORMATION

If more than one screen, show locations of each on sketch.