

Stone  
A 4  
1-21-69

MISSISSIPPI  
BOARD OF WATER COMMISSIONERS  
416 North State Street  
Jackson, Mississippi 39201

WATER WELL DRILLERS LOG

1-21 1969 date well completed  
L. W. Smith firm name  
Stone county well located

LANDOWNER:  
Hiram Davis  
Perkinstan  
(mailing address)

description of formations encountered	from	to
	Top S.	0
Clay	1	30
Sand	30	42
Clay	42	65
Sand	65	80
Clay		

WELL LOCATION:  
sec 96 T 2 S R 13 W  
8 miles W of Seligman  
(distance) (direction) (nearest town)

WELL PURPOSE:  
(home, irrigation, municipal, industrial)

WELL COMPLETION DATA:

(1) diameter (inches) 2"  
(2) total depth (feet) 83'  
(3) static water level (feet) 70' below top of ground.  
(4) casing Plastic (material) (depth)  
If telescope see back.  
(size)  
(5) screen 5' 78' (length) (depth to top)  
2 Plastic (size) (material)  
(6) pump 3/4 7 (HP) (yield gpm)  
Electric (type power)  
(7) electric log (yes or no)  
(organization running log)  
(8) how well bottom plugged B.W.

INDEX

969


FEB 4

MISS. BOARD OF WATER COMMISSIONERS

DRILLERS REMARKS:

If well telescopes please sketch and show depths.

GROUND LEVEL

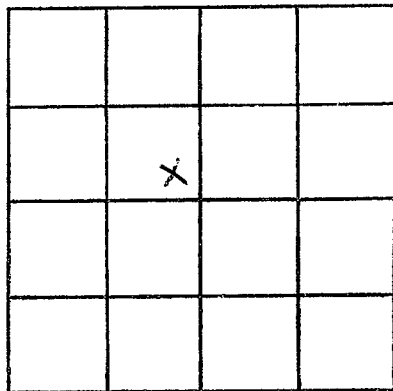

SECTION 26

Please indicate well location X.

ADDITIONAL INFORMATION

If more than one screen,  
show locations of each on sketch.