

STONE

A5

2-12-69

MISSISSIPPI  
 BOARD OF WATER COMMISSIONERS  
 416 North State Street  
 Jackson, Mississippi 39201

WATER WELL DRILLERS LOG

CODED

2-12

date well completed

1969 Parnell Henderson

firm name

Stowe

county well located

LANDOWNER: Mrs Carlos Robby

description of formations encountered

from to

Wiggins

TOP Soil

0 4

Red Clay

4 12

Fine Sand

12 28

Blue Clay

28 105

Fine Sand

105 112

Blue Clay

112 204

Fine Sand

204 225

Blue clay

225 231

Fine Sand

231 250

Coarse Sand

250 265

(mailing address)

WELL LOCATION:

sec. 20 T. 2 S. R. 13 W.  
14 miles W of Wiggins  
 (distance) (direction) (nearest town)

WELL PURPOSE: Industrial  
 (home, irrigation, municipal, industrial)

WELL COMPLETION DATA:

- (1) diameter (inches) 2
- (2) total depth (feet) 265
- (3) static water level (feet) 100 below top of ground.
- (4) casing Plastic, 260,  
 (material) (depth)
- if telescope see back.  
 (size)
- (5) screen 5, 260  
 (length) (depth to top)  
2", Plastic  
 (size) (material)
- (6) pump 1, 6  
 (HP) (yield gpm)  
Elect  
 (type power)
- (7) electric log \_\_\_\_\_  
 (yes or no)
- (organization running log)

(8) how well bottom plugged Backwash Valve

DRILLERS REMARKS:


INDEX

MAR 20 1969

MISS. BD. OF WATER COMMISSIONERS

If well telescopes please sketch and show depths.

GROUND LEVEL

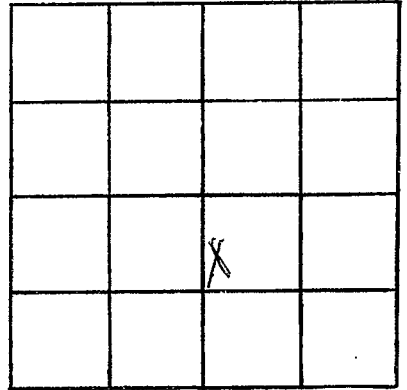

SECTION 20

Please indicate well location X.

ADDITIONAL INFORMATION

If more than one screen, show locations of each on sketch.