

Stone
A6
2-17-70

MISSISSIPPI
BOARD OF WATER COMMISSIONERS
416 North State Street
Jackson, Mississippi 39201

CODED

WATER WELL DRILLERS LOG

2-17 1970 Parnell Anderson Stone
date well completed firm name county well located

LANDOWNER: <u>Doug Smith</u>	description of formations encountered	from	to
<u>Lumberton Missa.</u> (mailing address)	<u>Top Soil</u>	0	3-
	<u>Pink Clay</u>	5	22
	<u>Fine Red Sand</u>	27	70
	<u>Medium Sand</u>	50	61
	<u>Coarse Sand</u>	61	74

LANDOWNER: Doug Smith

description of formations encountered	from	to
<u>Top Soil</u>	0	3-
<u>Pink Clay</u>	5	22
<u>Fine Red Sand</u>	27	70
<u>Medium Sand</u>	50	61
<u>Coarse Sand</u>	61	74

Lumberton Missa.
(mailing address)

WELL LOCATION:
sec. 20 T. 2 R. 13
11 miles west of W. Leake
(distance) (direction) (nearest town)

WELL PURPOSE: Home
(home, irrigation, municipal, industrial)


- WELL COMPLETION DATA:
- (1) diameter (inches) 2"
 - (2) total depth (feet) 74'
 - (3) static water level (feet) 50 below above top of ground.
 - (4) casing Plastic 68'
(material) (depth)
 - (size) if telescope see back.
 - (5) screen 6' 68'
(length) (depth to top)
 - 2" Plastic
(size) (material)
 - (6) pump 1 9
(HP) (yield gpm)
 - Electric
(type power)
 - (7) electric log no
(yes or no)
 - (organization running log)

(8) how well bottom plugged Backwash
Water

DRILLERS REMARKS:


CODED

MAR 6 1970

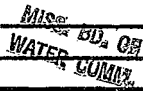MISS. BD. OF WATER COM. 

If well telescopes please sketch and show depths.

GROUND LEVEL

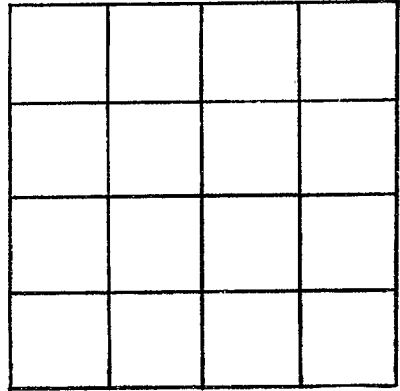

SECTION _____

Please indicate well location X.

ADDITIONAL INFORMATION

If more than one screen,
show locations of each on sketch.