

STONE
A 7
3-12-71

MISSISSIPPI
BOARD OF WATER COMMISSIONERS
416 North State Street
Jackson, Mississippi 39201

CODED

WATER WELL DRILLERS LOG

3-12 1971 date well completed
Lewis Smith firm name
Stone county well located

LANDOWNER:
Eddie Taylor
(mailing address)

description of formations encountered	from	to
Top S.	0	2
Clay	2	12
Sand	12	38
Clay		

WELL LOCATION:
sec. 27 T 2 S R 19 E W
8 miles W of Hattiesburg
(distance) (direction) (nearest town)

WELL PURPOSE:
(home, irrigation, municipal, industrial)

- WELL COMPLETION DATA:
- (1) diameter (inches) 2
 - (2) total depth (feet) 38
 - (3) static water level (feet) 8 below top of ground.
 - (4) casing Plastic (material) (depth)
 - (size) If telescope see back.
 - (5) screen 5' 33' (length) (depth to top)
 - (size) (material)
 - (6) pump 1 15 (HP) (yield gpm)
 - E (type power)
 - (7) electric log (yes or no)
 - (organization running log)
 - (8) how well bottom plugged Cap.

CODED


APR 19 1971

MISS. BD. OF
WATER COMMISSIONERS

DRILLERS REMARKS:

If well telescopes please sketch and show depths.

GROUND LEVEL

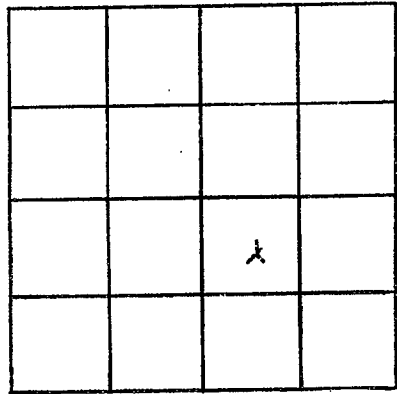

SECTION _____

Please indicate well location X.

ADDITIONAL INFORMATION

If more than one screen,
show locations of each on sketch.