

STONE
A8
3-16-71

MISSISSIPPI
BOARD OF WATER COMMISSIONERS
416 North State Street
Jackson, Mississippi 39201

CODED

WATER WELL DRILLERS LOG

3-16 1971 Lewis Smith Stone
date well completed firm name county well located

LANDOWNER:
Louis Seal
Wiggins Rd.
(mailing address)

description of formations encountered	from	to
<u>Tab 8</u>	<u>0</u>	<u>1</u>
<u>Clay</u>	<u>1.7</u>	<u>2.1</u>
<u>Sand</u>		
<u>Clay</u>		

WELL LOCATION:
sec. 19 T 2 S R. 13 W
11 miles W of Wiggins
(distance) (direction) (nearest town)

WELL PURPOSE:
(home, irrigation, municipal, industrial)

- WELL COMPLETION DATA:
- (1) diameter (inches) 2
 - (2) total depth (feet) 61
 - (3) static water level (feet) 90 below above top of ground.
 - (4) casing Plastic (material), (depth)
(size) if telescope see back.
 - (5) screen 5' (length), 56 (depth to top)
(size) (material)
 - (6) pump 1 (HP), 12 (yield gpm)
E (type power)
 - (7) electric log (yes or no)
(organization running log)
 - (8) how well bottom plugged Cap.

CODED


APR 19 1971

MISS. DE. OF
WATER COMMISSIONERS

DRILLERS REMARKS:

If well telescopes please sketch and show depths.

GROUND LEVEL

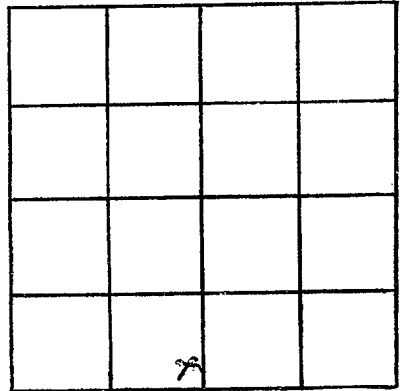

SECTION _____

Please indicate well location X.

ADDITIONAL INFORMATION

If more than one screen,
show locations of each on sketch.