

STONE  
A 9  
4-8-71

MISSISSIPPI  
BOARD OF WATER COMMISSIONERS  
416 North State Street  
Jackson, Mississippi 39201

**CODED**

WATER WELL DRILLERS LOG

4-8-71 19 Darnell Anderson Stone  
date well completed firm name county well located

LANDOWNER: David Lee  
Rt  
Perkinston, Miss  
(mailing address)

description of formations encountered	from	to
<u>TOP Soil</u>	<u>0</u>	<u>3</u>
<u>Red Clay</u>	<u>3</u>	<u>14</u>
<u>Spindle clay</u>	<u>14</u>	<u>19</u>
<u>Pink clay</u>	<u>19</u>	<u>34</u>
<u>Fine sand</u>	<u>34</u>	<u>40</u>
<u>Blue clay</u>	<u>50</u>	<u>65</u>
<u>Fine sand</u>	<u>65</u>	<u>73</u>
<u>Coarse sand</u>	<u>73</u>	<u>81</u>

WELL LOCATION:  
sec. 2 T. 2 S. R. 13 W.  
(distance) miles (direction) of (nearest town)

WELL PURPOSE: Home  
(home, irrigation, municipal, industrial)

WELL COMPLETION DATA:  
(1) diameter (inches) 2  
(2) total depth (feet) 81  
(3) static water level (feet) 60' below top of ground.  
(4) casing Asbestos 75'  
(material) (depth)  
2' if telescope see back.  
(size)  
(5) screen 6' 75'  
(length) (depth to top)  
2 Elastic  
(size) (material)  
(6) pump 1 (HP) (yield gpm)  
(type power)  
(7) electric log no (yes or no)  
(organization running log)  
(8) how well bottom plugged  
Barb Wash Valve

**CODED**


JUN 3 1971

DRILLERS REMARKS:

MISS. Bd. OF  
WATER COMMISSIONERS

If well telescopes please sketch and show depths.

GROUND LEVEL

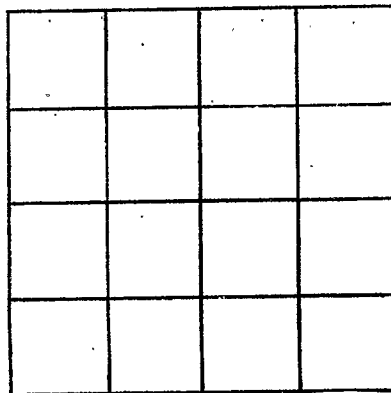

SECTION \_\_\_\_\_

Please indicate well location X.

ADDITIONAL INFORMATION

If more than one screen, show locations of each on sketch.