

STONE
A 10
4-23-71

MISSISSIPPI
BOARD OF WATER COMMISSIONERS
416 North State Street
Jackson, Mississippi 39201

CODED

WATER WELL DRILLERS LOG

4-23-1971 Parnee Anderson Stone
date well completed firm name county well located

LANDOWNER: F.m. Christy

(mailing address)

WELL LOCATION:
sec. 2 T. 2 S. R. 13 W.
11 miles E of Wiggins
(distance) (direction) (nearest town)

description of formations encountered	from	to
TOP SOIL	0	2
Red Clay	2	26
Fine Sand	26	32
White Clay	32	46
Blue Clay	46	103
Fine Sand	103	121
Blue Clay	121	144
Fine Sand	144	158
Coarse Sand	158	169

WELL PURPOSE: Home
(home, irrigation, municipal, industrial)

WELL COMPLETION DATA:
 (1) diameter (inches) 2"
 (2) total depth (feet) 169
 (3) static water level (feet) 70 below top of ground.
 (4) casing Elastic 1 1/4' (material) (depth)
2" (size) If telescope see back.
 (5) screen 5' (length) 164 (depth to top)
2" (size) Elastic (material)
 (6) pump 1 (HP) 8 (yield, gpm)
Electric (type power)
 (7) electric log No (yes or no)
 (organization running log)
 (8) how well bottom plugged Backward Valve

CODED


JUN 9 1971

DRILLERS REMARKS:

MISS. BD. OF
WATER COM.

If well telescopes please sketch and show depths.

GROUND LEVEL

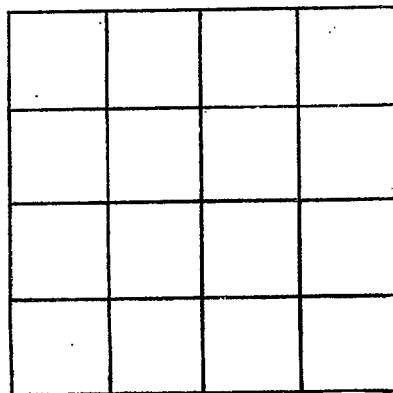

SECTION _____

Please indicate well location X.

ADDITIONAL INFORMATION

If more than one screen, show locations of each on sketch.