

STONE
A 12
7-7-70

MISSISSIPPI
BOARD OF WATER COMMISSIONERS
416 North State Street
Jackson, Mississippi 39201

CODED

WATER WELL DRILLERS LOG

7-7
date well completed

1970 Perwell Anderson
firm name

Stone
county well located

LANDOWNER: <u>J. B. Baradas</u>	description of formations encountered	from	to
<u>Wiggins</u>	Top Soil	0	3
(mailing address)	Red Clay	3	18
WELL LOCATION:	Fine Sand	18	26
sec. <u>31</u> T. <u>2</u> S. R. <u>13</u> W.	Red Clay	26	48
<u>15</u> miles <u>W</u> of <u>Wiggins</u>	Coarse Sand	48	64
(distance) (direction) (nearest town)			
WELL PURPOSE: <u>Home</u> (home, irrigation, municipal, industrial)			
WELL COMPLETION DATA:			
(1) diameter (inches) <u>2</u>			
(2) total depth (feet) <u>64</u>			
(3) static water level (feet) <u>39</u> below top of ground.			
(4) casing <u>Plastic</u> (<u>58</u>) (material) (depth)			
_____ if telescope see back. (size)			
(5) screen <u>6</u> (<u>58</u>) (length) (depth to top)			
<u>2</u> (<u>Plastic</u>) (size) (material)			
(6) pump <u>1/2</u> (<u>5</u>) (HP) (yield gpm)			
<u>Elect</u> (type power)			
(7) electric log _____ (yes or no)			
_____ (organization running log)			
(8) how well bottom plugged <u>Backwash Valve</u>			
DRILLERS REMARKS:			


CODED

JUN 11 1971

MISS. BD. OF
WATER COMM.

If well telescopes please sketch and show depths.

GROUND LEVEL

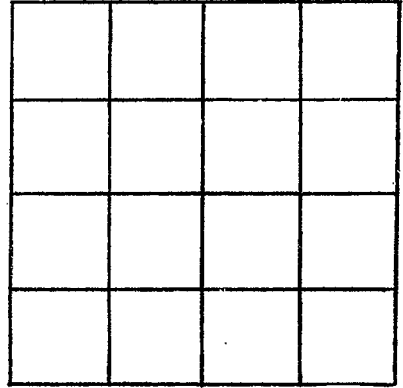

SECTION _____

Please indicate well location X.

ADDITIONAL INFORMATION

If more than one screen,
show locations of each on sketch.