

MISSISSIPPI
BOARD OF WATER COMMISSIONERS
416 North State Street
Jackson, Mississippi 39201

CODED

Stone
A15
11-24-71

WATER WELL DRILLERS LOG

11-24-71 date well completed
1971 firm name
Stone county well located

LANDOWNER: Norman Hadwier

Lumber town, Miss

(mailing address)

WELL LOCATION:

sec. 30 T. 2 S. R. 13 W.
15 miles W of Wiggins
(distance) (direction) (nearest town)

WELL PURPOSE: Home
(home, irrigation, municipal, industrial)

WELL COMPLETION DATA:

- (1) diameter (inches) 2
- (2) total depth (feet) 83
- (3) static water level (feet) 52 below above top of ground.
- (4) casing Plastic, 78 (material), (depth)
- (size) if telescope see back.
- (5) screen 5, 78 (length), (depth to top)
- 2, Plastic (size), (material)
- (6) pump 1, 10 (HP), (yield gpm)
- ElecT (type power)
- (7) electric log (yes or no)
- (organization running log)
- (8) how well bottom plugged Back was 1/2 do

description of formations encountered

from to

top Soil	0	3
Red Sandy Clay	3	18
Red Sand	18	31
Red Clay with sand ST	31	70
Coarse Sand & Gravel	70	83


CODED

DRILLERS REMARKS:

DEC 8 1972

If well telescopes please sketch and show depths.

GROUND LEVEL

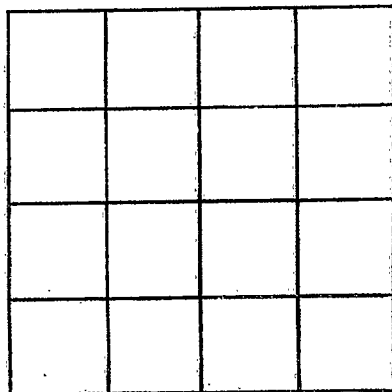

SECTION _____

Please indicate well location X.

ADDITIONAL INFORMATION

If more than one screen,
show locations of each on sketch.