

STONE
A 16
10-28-71

MISSISSIPPI
BOARD OF WATER COMMISSIONERS
416 North State Street
Jackson, Mississippi 39201

CODED

WATER WELL DRILLERS LOG

10-28 1971 Parnell Anderson Stone
date well completed firm name county well located

LANDOWNER: Parthy Lee
RT-3 Lumberton
(mailing address)

description of formations encountered	from	to
Top Soil	0	3
Red Sand	3	21
Red Clay	21	34
Fine Sand	34	46
Coarse Sand	46	63

WELL LOCATION:
sec. 19 T. 2 S R. 13 W
15 miles W of Wiggins
(distance) (direction) (nearest town)

CODED

WELL PURPOSE:
(home, irrigation, municipal, industrial)


- WELL COMPLETION DATA:
- (1) diameter (inches) 2
 - (2) total depth (feet) 63
 - (3) static water level (feet) 40 below above top of ground.
 - (4) casing PVC 58 (material) (depth)
 - (size) if telescope see back.
 - (5) screen 5 58 (length) (depth to top)
 - 2 PVC (size) (material)
 - (6) pump 1/2 5 (HP) (yield gpm)
 - Eloc (type power)
 - (7) electric log (yes or no)
 - (organization running log)
 - (8) how well bottom plugged

DRILLERS REMARKS:

DEC 8 1972

If well telescopes please
sketch and show depths.

GROUND LEVEL

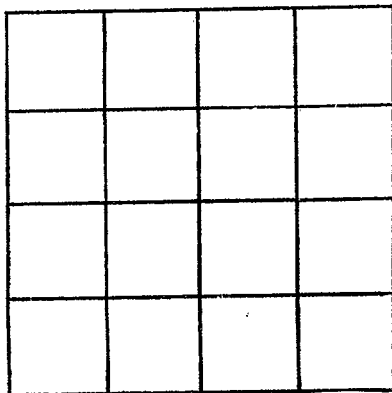

SECTION _____

Please indicate well location X.

ADDITIONAL INFORMATION

If more than one screen,
show locations of each on sketch.