

STONE
A17
12-17-71

MISSISSIPPI
BOARD OF WATER COMMISSIONERS
416 North State Street
Jackson, Mississippi 39201

WATER WELL DRILLERS LOG

CODED

12-17 1971 Parnell Anderson Stone
date well completed firm name county well located

LANDOWNER: Otera Davis
Lumberton Miss
(mailing address)

description of formations encountered	from	to
Top Soil	0	3
Red Clay	3	18
Red Silt	18	27
Blue Clay	27	121
Fine Sand	121	130
Coarse Sand	130	138

WELL LOCATION:
sec. 16 T 2 N R. 13 E
S W
13 miles W of Wiggins
(distance) (direction) (nearest town)

WELL PURPOSE: Home
(home, irrigation, municipal, industrial)

- WELL COMPLETION DATA:
- (1) diameter (inches) 2"
- (2) total depth (feet) 138
- (3) static water level (feet) 100' below top of ground.
- (4) casing Plastic, 133,
(material) (depth)
- _____ if telescope see back.
(size)
- (5) screen 5, 133
(length) (depth to top)
- 2, Plastic
(size) (material)
- (6) pump 1, 6
(HP) (yield gpm)
- Flect
(type power)
- (7) electric log _____
(yes or no)
- _____ (organization running log)
- (8) how well bottom plugged
Back was 1/2 in

CODED


DRILLERS REMARKS:

DEC 8 1971

MISS. BD. OF
WATER COM.

If well telescopes please
sketch and show depths.

GROUND LEVEL

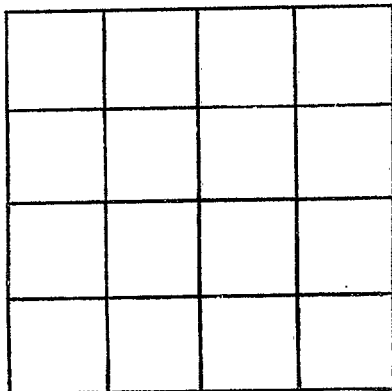

SECTION _____

Please indicate well location X.

ADDITIONAL INFORMATION

If more than one screen,
show locations of each on sketch.