

STONE
A18
12-18-71

MISSISSIPPI
BOARD OF WATER COMMISSIONERS
416 North State Street
Jackson, Mississippi 39201

CODED

WATER WELL DRILLERS LOG

12-18 1971 Parnell Anderson Stone
date well completed firm name county well located

LANDOWNER: Buford Smith
Lumberton Miss
(mailing address)

description of formations encountered	from	to
Top Soil	0	2
Red Clay	3	12
Red Clay & Gravel	12	28
Fine Sand	28	41
Coarse Sand & Gravel	41	58

WELL LOCATION:
sec. 33 T. 2 S R. 13 W
miles of (distance) (direction) of (nearest town)

WELL PURPOSE: Home
(home, irrigation, municipal, industrial)

WELL COMPLETION DATA:

(1) diameter (inches) 2"
(2) total depth (feet) 58'
(3) static water level (feet) 32 below above top of ground.
(4) casing Plastic, 53 (material) (depth)
(size) if telescope see back.
(5) screen 5 48 (length) (depth to top)
(size) (material)
(6) pump 1 11 (HP) (yield gpm)
Elect (type power)
(7) electric log (yes or no)
(organization running log)

CODED

(8) how well bottom plugged
Back Wash Valve


DRILLERS REMARKS:

DEC 8 1971

MISSISSIPPI BOARD OF WATER COMMISSIONERS

If well telescopes please sketch and show depths.

GROUND LEVEL

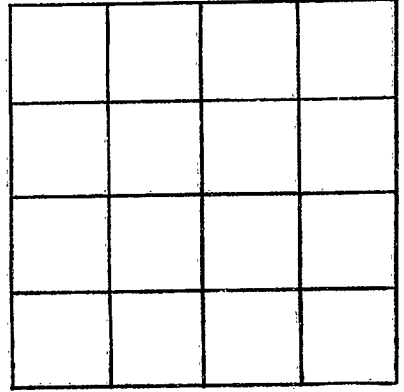

SECTION _____

Please indicate well location X.

ADDITIONAL INFORMATION

If more than one screen,
show locations of each on sketch.