

STONE
A 19
3-2-72

MISSISSIPPI
BOARD OF WATER COMMISSIONERS
416 North State Street
Jackson, Mississippi 39201

CODED

WATER WELL DRILLERS LOG

3-2 1972 Parwell Anderson Stone
date well completed firm name county well located

LANDOWNER: Larry LOTT

Wiggins
OO

(mailing address)

WELL LOCATION:

sec. 2 T 2 S R 13 E W
9 miles N-W of Wiggins
(distance) (direction) (nearest town)

WELL PURPOSE: Home
(home, irrigation, municipal, industrial)

WELL COMPLETION DATA:

- (1) diameter (inches) 2
(2) total depth (feet) 128
(3) static water level (feet) 75 below top of ground.
(4) casing Plastic, 122 (material) (depth)

(size) if telescope see back.

- (5) screen 5', 122 (length) (depth to top)
2", Plastic (size) (material)

- (6) pump 1 (HP) 9 (yield gpm)
Elec (type power)

- (7) electric log (yes or no)

(organization running log)

- (8) how well bottom plugged
Backwash Valve

description of formations encountered

from to

Top Soil	0	2
Red Clay	2	12
Fine Sand	12	19
Red Clay	19	34
Fine Sand	34	47
Blue Clay	47	103
Fine Sand	103	115
Coarse Sand	115	128


CODED

DRILLERS REMARKS:

ENC 11 1072

If well telescopes please sketch and show depths.

GROUND LEVEL

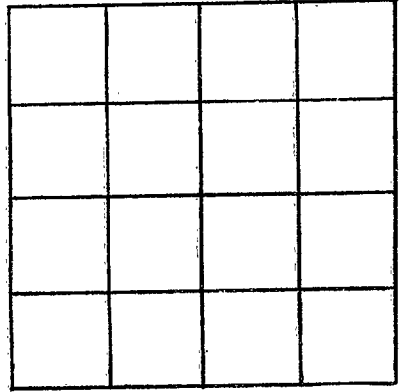

SECTION _____

Please indicate well location X.

ADDITIONAL INFORMATION

If more than one screen, show locations of each on sketch.