

STONE
A23
10-1-73

MISSISSIPPI
BOARD OF WATER COMMISSIONERS
416 North State Street
Jackson, Mississippi 39201

CODED

WATER WELL DRILLERS LOG

10-1-1973 date well completed
D. P. Anderson firm name
Stone county well located

LANDOWNER:
Gene Brown
Rt 2 Perk
(mailing address)

description of formations encountered	from	to
Top Soil	0	3
fine sand	3	50
Coarse sand	50	74

WELL LOCATION:
sec. 30 T 2 S R 13 W
miles W Perkinton
(distance) (direction) (nearest town)

WELL PURPOSE: HOME
(home, irrigation, municipal, industrial)

- WELL COMPLETION DATA:
- (1) diameter (inches) 2"
 - (2) total depth (feet) 74'
 - (3) static water level (feet) 45' - below top of ground
 - (4) casing Plastic, 69'
(material) (depth)
 - (size) if telescope see back.
 - (5) screen 5' 169'
(length) (depth to top)
 - 2" Plastic
(size) (material)
 - (6) pump 1 9
(HP) (yield gpm)
 - Elect
(type power)
 - (7) electric log no
(yes or no)
 - (organization running log)

CODED

(8) how well bottom plugged
Back well valve


DRILLERS REMARKS:

MAINT. BY [unclear]

REC'D. OF
STATE COMM.

If well telescopes please sketch and show depths.

GROUND LEVEL

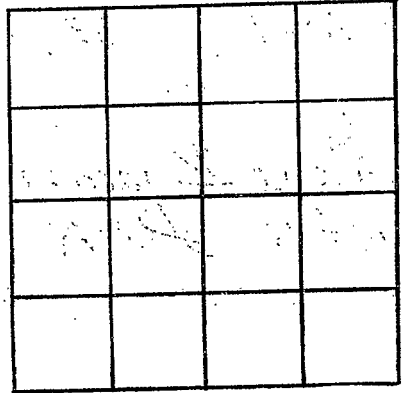

SECTION _____

Please indicate well location X.

ADDITIONAL INFORMATION

If more than one screen,
show locations of each on sketch.