

STONE
A25
6-6-74

MISSISSIPPI
BOARD OF WATER COMMISSIONERS
416 North State Street
Jackson, Mississippi 39201

CODED

WATER WELL DRILLERS LOG

6-6
date well completed

1974 Pamell Anderson
firm name

Stone
county well located

LANDOWNER:

Bonie Smith
Rt 3 Lumberton
(mailing address)

description of formations
encountered

from to

Top Soil 0 4

Red Clay 4 18

Thin Sand 18 24

Coarse Sand 24 55

WELL LOCATION:

sec. 19 T 2 S R. 13 W
13 miles AW of Wlog
(distance) (direction) (nearest town)

WELL PURPOSE: HOME
(home, irrigation, municipal, industrial)

WELL COMPLETION DATA:

- (1) diameter (inches) 2"
(2) total depth (feet) 55'
(3) static water level (feet) 13' below
top of ground. above
(4) casing Plastic, 550'
(material) (depth)

(size) if telescope see back.

- (5) screen 5', 50'
(length) (depth to top)
5", Plastics
(size) (material)

- (6) pump 1 9
(HP) (yield gpm)
Elect
(type power)

- (7) electric log no
(yes or no)

(organization running log)

- (8) how well bottom plugged
Plugged

DRILLERS REMARKS:

CODED


RECEIVED

JUL - 5 1974

MISS. BD. OF WATER COMMISSIONERS

If well telescopes please sketch and show depths.

GROUND LEVEL

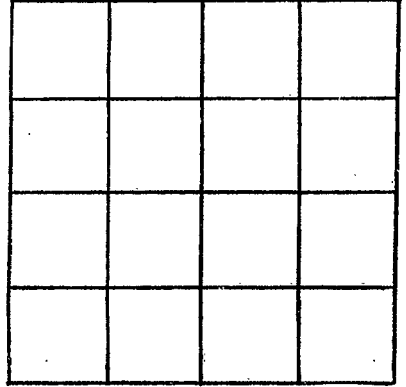

SECTION _____

Please indicate well location X.

ADDITIONAL INFORMATION

If more than one screen, show locations of each on sketch.