

STONE
A26
6-13-74

MISSISSIPPI
BOARD OF WATER COMMISSIONERS
416 North State Street
Jackson, Mississippi 39201

CODED

WATER WELL DRILLERS LOG

6-13 1974 Kornell Anderson Stone
date well completed firm name county well located

LANDOWNER:
Buford Smith
Rt 2 Oak
(mailing address)

description of formations encountered	from	to
<u>Top Soil</u>	<u>0</u>	<u>3</u>
<u>Red Clay</u>	<u>4</u>	<u>25</u>
<u>Fine Sand</u>	<u>25</u>	<u>42</u>
<u>Coarse Sand</u>	<u>3/2</u>	<u>64</u>

WELL LOCATION:
sec. 33 T. 6 S. R. 13 W.
12 miles W of Wegg
(distance) (direction) (nearest town)

WELL PURPOSE: HOME
(home, irrigation, municipal, industrial)

WELL COMPLETION DATA:

(1) diameter (inches) 2"

(2) total depth (feet) 64'

(3) static water level (feet) 35' below top of ground.

(4) casing Plastic 59'
(material) (depth)

_____ if telescope see back.
(size)

(5) screen 5' 59'
(length) (depth to top)

2" Plastic
(size) (material)

(6) pump 1 9
(HP) (yield gpm)

Elect
(type power)

(7) electric log no
(yes or no)

_____ (organization running log)

CODED


(8) how well bottom plugged Backwash valve

RECEIVED
JUL 5 1974

DRILLERS REMARKS:

If well telescopes please sketch and show depths.

GROUND LEVEL

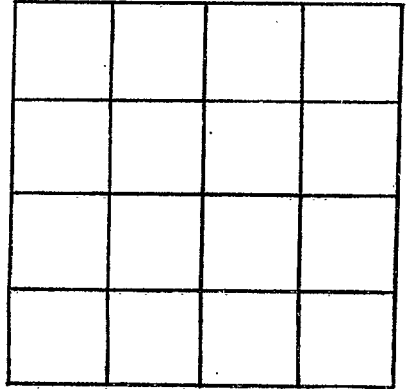

SECTION _____

Please indicate well location X.

ADDITIONAL INFORMATION

If more than one screen,
show locations of each on sketch.