

STONE
A27
3-17-75

MISSISSIPPI
BOARD OF WATER COMMISSIONERS
416 North State Street
Jackson, Mississippi 39201

CODED

WATER WELL DRILLERS LOG

3-17 1975 Pernell Anderson Stone
date well completed firm name county well located

LANDOWNER:
Robert Barnett

(mailing address)

description of formations encountered	from	to
<u>Top Soil</u>	<u>0</u>	<u>4</u>
<u>Red Sand</u>	<u>4</u>	<u>18</u>
<u>Coarse Sand</u>	<u>18</u>	<u>72</u>

WELL LOCATION:
sec. 32 T 2 S R. 13 E W
10 miles W of Wiggins
(distance) (direction) (nearest town)

WELL PURPOSE: HOME
(home, irrigation, municipal, industrial)

- WELL COMPLETION DATA:
- (1) diameter (inches) 2"
 - (2) total depth (feet) 75'
 - (3) static water level (feet) 43 below top of ground.
 - (4) casing Plastic, 67'
(material) (depth)
 - (size) if telescope see back.
 - (5) screen 5', 67'
(length) (depth to top)
 - 2", Plastic
(size) (material)
 - (6) pump 1, 10
(HP) (yield gpm)
 - Elect
(type power)
 - (7) electric log no
(yes or no)
 - (organization running log)

(8) how well bottom plugged?
Backfilled with

DRILLERS REMARKS:


CODED

REGISTRATION
MAR 31 1975

MISS. DD. OF WATER COMMISSIONERS

If well telescopes please
sketch and show depths.

GROUND LEVEL

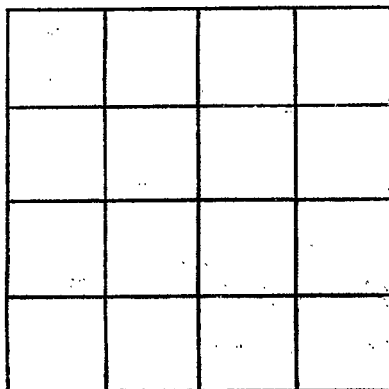

SECTION _____

Please indicate well location X.

ADDITIONAL INFORMATION

If more than one screen,
show locations of each on sketch.