

Stone  
A 28  
6-6-75

MISSISSIPPI  
BOARD OF WATER COMMISSIONERS  
416 North State Street  
Jackson, Mississippi 39201

CODED

WATER WELL DRILLERS LOG

6-6 1975 Parnell Anderson Stone  
date well completed firm name county well located

LANDOWNER:  
R J Purley  
(mailing address)

WELL LOCATION:  
sec. 12 T 2 N R 13 E 13Q  
6 miles NWN of Wiggins  
(distance) (direction) (nearest town)

WELL PURPOSE: HOME  
(home, irrigation, municipal, industrial)

WELL COMPLETION DATA:  
(1) diameter (inches) 2"  
(2) total depth (feet) 105'  
(3) static water level (feet) 25' below top of ground.  
(4) casing Plastic 100'  
(material) (depth)  
(size) if telescope see back.  
(5) screen 5" 100'  
(length) (depth to top)  
2" Plastic  
(size) (material)  
(6) pump 1 10  
(HP) (yield gpm)  
Elect  
(type power)  
(7) electric log no.  
(yes or no)  
(organization running log)

description of formations encountered	from	to
Top Soil	0	4
Thin clay	4	28
Blue clay	28	30
fine sand	30	95
Coarse sand	95	100


(8) how well bottom plugged  
Back with water

DRILLERS REMARKS:

RECEIVED  
APR 2 1975

If well telescopes please sketch and show depths.

GROUND LEVEL

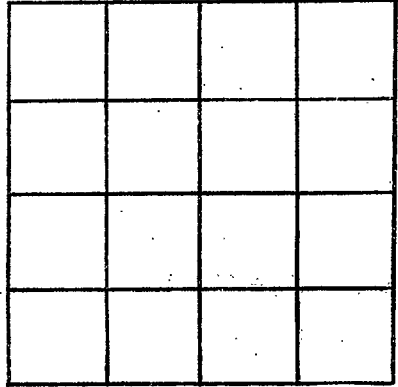

SECTION \_\_\_\_\_

Please indicate well location X.

ADDITIONAL INFORMATION

If more than one screen, show locations of each on sketch.