

Stone
A 29
10-18-79

MISSISSIPPI
BOARD OF WATER COMMISSIONERS
416 North State Street
Jackson, Mississippi 39201

CODED

WATER WELL DRILLERS LOG

10-18-79 Griner Drilling Stone
date well completed firm name county well located

LANDOWNER:
Getty Oil Corporation
P.O. Box 16878
Mobile, Alabama
(mailing address) 36616

description of formations encountered	from	to
Sand + gravel	0	119
clay	119	329
sand	329	392
clay	392	581
clay & sand	581	602
sand	602	623
clay + sand	623	665
clay, shell, clay	665	686

WELL LOCATION: 1500' N + 1500' E
sec. 12 T 2 N R 13 E of
West of Wiggins (distance) (direction) (nearest town)
Winston

WELL PURPOSE: oil field supply
(home, irrigation, municipal, industrial)

WELL COMPLETION DATA:

- (1) diameter (inches) 3"
- (2) total depth (feet) 708'
- (3) static water level (feet) 165' below top of ground.
- (4) casing steel 4 7/8" (material) (depth)
3" (size) if telescope see back.
- (5) screen 42' 429' (length) (depth to top)
3" perforated (size) (material)
- (6) pump AC (HP) 60 (yield gpm)
(type power)
- (7) electric log (yes or no)
- (organization running log)

CODED
119 - 329 - Clay
329 - 429 - Clay
429 - 471 Sand


(8) how well bottom plugged orange peel

DRILLERS REMARKS:

DEPT. OF NATURAL RESOURCES
BUREAU OF LAND & WATER RESOURCES
NOV 18 1979
RECEIVED

If well telescopes please sketch and show depths.

GROUND LEVEL

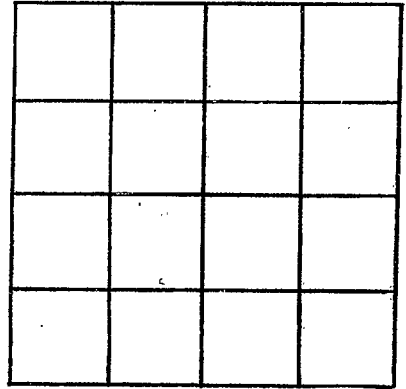

SECTION _____

Please indicate well location X.

ADDITIONAL INFORMATION

If more than one screen,
show locations of each on sketch.