

County: STONE  
 Permit #: \_\_\_\_\_  
 Driller: \_\_\_\_\_  
 Date drilling completed: \_\_\_\_\_

**State Well Report  
 Part 1 - Driller's Log**

Mississippi Department of Environmental Quality  
 Office of Land and Water Resources  
 P.O. Box 10631  
 Jackson, MS 39289-0631  
 (601)961-5210  
 (601)354-6938 (fax)

For Office Use Only:  
 Aquifer: \_\_\_\_\_  
 Well #: A 59  
 L. S. Elevation: \_\_\_\_\_  
 E-log #: \_\_\_\_\_

*State Law requires that this report be prepared by the license holder responsible for the work and filed with the Department at the above address within 30 days of completion of drilling of the well or borehole.*

Information on Well Owner (Landowner if borehole is not for a water well)	Well or Borehole Location
Owner Name: <u>Keith Dedeaux</u>	Latitude: <u>30° 51.32"</u> Longitude: <u>89° 17.53"</u>
Mailing Address: <u>Will Lee Rd.</u>	Method of Lat/Long (circle one): Conventional Survey, USGS quad, <u>Hand-held GPS</u> , Survey-grade GPS
<u>Wiggins MS 39577</u> City State Zip Code	<u>SW 1/4 NE 1/4 Sec 21 Twn 2S Rng 13W</u>
Telephone No. <u>(228) 669-3105</u>	Distance <u>9.5</u> Miles Direction <u>West</u> of Nearest Town <u>Wiggins</u>

**Well / Borehole Data**

Date drilling started: 3-4-14 Date drilling completed: 3-19-14 Hole depth: 154' Hole diameter: 6.5"

Location of the source of any surface water used for drilling: N/A

Method of dosing and volume of Chlorine used in drilling and development: N/A

Logs run (circle all applicable): No log run Electric Gamma Ray Density Sonic Neutron Other: \_\_\_\_\_

Name of organization running log(s): \_\_\_\_\_

Purpose of borehole (check one): Water Well  Geotechnical/Geological Investigation \_\_\_\_\_ Ground Source Heat Pump \_\_\_\_\_

Seismic Survey \_\_\_\_\_ Other (describe) \_\_\_\_\_

*If drilling is not related to water well construction, skip the remainder of this block*

Purpose of Well (check one): Home  Industrial \_\_\_\_\_ Public Supply \_\_\_\_\_ Irrigation \_\_\_\_\_ Fish Culture \_\_\_\_\_ Other: \_\_\_\_\_

If a flowing well, method of flow regulation: Valve \_\_\_\_\_ Other (describe) \_\_\_\_\_

Static Water Level: 90 feet above or below (circle one) land surface Date measured: 3-7-14

Method of Measurement (circle one) steel tape electric tape air line other: \_\_\_\_\_

Well depth: 155' Well grouted to a depth of 10 feet Type of grout (circle one): Neat Cement Bentonite Mix

Casing length: 135 feet Casing diameter: 4 inches Type of casing: PVC

Screen length: 20 feet Screen diameter: 4 inches Type of screen: PVC

Screen slot size: 0.008 inches Setting depth: From 135 feet to 155 feet

Type of completion (circle all applicable): Gravel packed Underreamed Telescoped Open hole Natural Development

Other (describe): \_\_\_\_\_

Top of lap pipe or reduction in casing: N/A feet. *If telescoped or more than one screen, describe on next page*

RECEIVED

APR 07 2014

BY: OLWR

A 59

The sketch below only required for water wells

Description of formations encountered must be provided for all wells and boreholes, unless specifically exempted by regulations

If well telescopes, show depths on sketch.

Ground Level →

Description of Formations Encountered	From (depth)	To (depth)
lt br c ls d	0	20'
Blue gr y cl	20'	60'
gr c ls d	60'	94'
ja r sd	94'	115'
br ls d	115'	155'

If more than one screen, show location of each on sketch

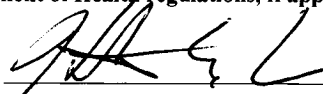
Sketch the property layout and include the following: 1) the well location; 2) any permanent structures on the property that may aid in locating the well; 3) any roads, power lines, or other items that may aid in locating the property and the well; 4) a north arrow.

Landowner Name: \_\_\_\_\_

Form: OLWR-SWR-1A

I certify that the well/borehole was drilled, constructed, and completed in accordance with all applicable requirements of the Mississippi Department of Environmental Quality and the Mississippi Department of Health regulations, if applicable, and state laws.

Heath S. Williams 0-790 \_\_\_\_\_  
 Print Name of Responsible Licensee and License No. Date

 **RECEIVED**  
 Signature of Licensee

APR 07 2014

**BY: OLWR**

# STATE WELL REPORT

## Part 2

**Pump Installer's Completion Report**  
 Mississippi Department of Environmental Quality  
 Office of Land and Water Resources  
 P.O. Box 10631  
 Jackson, MS 39289-0631  
 (601)961-5210  
 (601)354-6938 (fax)

County: \_\_\_\_\_  
 Permit #: \_\_\_\_\_  
 Driller: \_\_\_\_\_  
 Date completed: \_\_\_\_\_  
*Copy information from block on Part 1*

**For Office Use Only:**

Aquifer: \_\_\_\_\_  
 Well #: A 59  
 Elevation: \_\_\_\_\_

*This part of the report must be completed by a licensed water well contractor or a licensed pump installer. A copy of Part 1 of the report must be attached and both parts filed with the Department at the above address within 30 days of well completion.*

Well Owner Information	Well Location
Owner Name: <u>Keith Dedeaux</u>	Latitude: <u>30°51'32"</u> Longitude: <u>89°17'53"</u>
Mailing Address: <u>Will Lee Rd.</u>	Method of Lat/Long (check one): Conventional Survey <input type="checkbox"/> , USGS quad <input checked="" type="checkbox"/> , Hand-held GPS <input type="checkbox"/> , Survey-grade GPS <input type="checkbox"/>
<u>Wiggins MS 39577</u> City State Zip Code	<u>SW ¼ NE ¼ Sec 21 T 2S R 13W</u>
Telephone No. <u>(228) 669-3105</u>	Distance Direction Nearest Town <u>9.5 Miles West of Wiggins</u>

Pump Type Circle one	Power Type Circle one
Air Lift      Jet <u>Submersible</u>	Diesel Engine      Gasoline Engine      Natural Gas
Bucket      Piston      Turbine	<u>Electric Motor</u> Hand      Tractor PTO
Centrifugal      Rotary      Flowing Well	Windmill      Other (specify): _____
Other (specify): _____	Horse Power Rating of Motor: <u>0.5</u>
Date Pump Installed: <u>3-19-14</u>	Setting Depth: <u>140</u> feet
Rated Pump Capacity: <u>5</u> Gallons Per Minute	Number of Stages: <u>15</u>

Pump Test Data	Method of Measuring Water Level Circle one
Date Well Tested: <u>3-19-14</u>	Air Line      Electric Measuring Line <u>Steel Tape</u>
Static Water Level (A): _____ Feet Below Land Surface	Other (specify): _____
Pumping Water Level (B): _____ Feet Below Land Surface	For flowing well, measured shut in head: _____ feet
Drawdown [(B) - (A)]: _____ Feet Below Land Surface	Well yielded _____ GPM with a drawdown of _____ feet after _____ hours of pumping
Test Pumping Rate: <u>8</u> Gallons Per Minute	
Duration of Pump Test (minimum 4 hours): <u>4</u> hours	

I HEREBY CERTIFY that the above statements are true to the best of my knowledge.

Heath S. Williams 0-790      [Signature]  
 Print Name of Pump Installer and License No. (if applicable)      Signature of Pump Installer

**RECEIVED**  
 Form: OLWR-SWR-1B  
 APR 07 2014  
**BY: OLWR**