

Stone
A 2000
11/3/75

MISSISSIPPI
BOARD OF WATER COMMISSIONERS
416 North State Street
Jackson, Mississippi 39201

WATER WELL DRILLERS LOG

11-3 1975 Paine O Anderson Stone
date well completed firm name county well located

LANDOWNER:	description of formations encountered	from	to
<u>Otha Davis</u>	<u>Top Soil</u>	<u>0</u>	<u>4</u>
(mailing address)	<u>Red Sand</u>	<u>4</u>	<u>20</u>
WELL LOCATION: sec. <u>19</u> T <u>2</u> S R. <u>13</u> W <u>13a</u> <u>12</u> miles <u>W</u> of <u>Wleighs</u> (distance) (direction) (nearest town)	<u>Coarse Sand</u>	<u>20</u>	<u>65</u>
WELL PURPOSE: <u>HOME</u> (home, irrigation, municipal, industrial)			
WELL COMPLETION DATA:			
(1) diameter (inches) <u>2"</u>			
(2) total depth (feet) <u>65'</u>			
(3) static water level (feet) <u>45'</u> below top of ground.			
(4) casing <u>Plastic</u> , <u>60'</u> (material) (depth)			
(size) If telescope see back.			
(5) screen <u>5'</u> , <u>60'</u> (length) (depth to top)			
<u>2"</u> , <u>Plastic</u> (size) (material)			
(6) pump <u>1</u> , <u>8</u> (HP) (yield gpm)			
<u>Elect</u> (type power)			
(7) electric log <u>no</u> (yes or no)			
(organization running log)			
(8) how well bottom plugged? <u>Backwash Valve</u>			
DRILLERS REMARKS:			

DISCOUNT
KISSISSIPPI


DEC 4 1975

MISS

1975

If well telescopes please sketch and show depths.

GROUND LEVEL

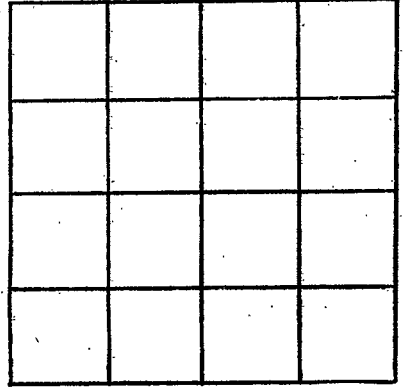

SECTION _____

Please indicate well location X.

ADDITIONAL INFORMATION

If more than one screen, show locations of each on sketch.