

Stone
A 200
12-9-75

MISSISSIPPI
BOARD OF WATER COMMISSIONERS
416 North State Street
Jackson, Mississippi 39201

WATER WELL DRILLERS LOG

12-9 1975 Painell Anderson Stone
date well completed firm name county well located


LANDOWNER:	description of formations encountered	from	to
<u>Earl Braden</u>	<u>Top Soil</u>	<u>0</u>	<u>4</u>
(mailing address)	<u>Sandy Red Clay</u>	<u>4</u>	<u>28</u>
WELL LOCATION:	<u>Coarse Sand</u>	<u>28</u>	<u>48</u>
sec. <u>34</u> T <u>2</u> R <u>13</u> S <u>W</u>			
(distance) miles _____ of _____ (direction) (nearest town)			
WELL PURPOSE: <u>HOME</u> (home, irrigation, municipal, industrial)			
WELL COMPLETION DATA:			
(1) diameter (inches) <u>2"</u>			
(2) total depth (feet) <u>48'</u>			
(3) static water level (feet) <u>35</u> below top of ground.			
(4) casing <u>Plastic 43'</u> (material) (depth)			
(size) If telescope see back.			
(5) screen <u>57'</u> <u>43'</u> (length) (depth to top)			
<u>2"</u> <u>Plastic</u> (size) (material)			
(6) pump <u>1</u> <u>7</u> (HP) (yield gpm)			
<u>Cent</u> (type power)			
(7) electric log <u>no</u> (yes or no)			
(organization running log)			
(8) how well bottom plugged <u>Plugged</u>			
DRILLERS REMARKS:			

RECEIVED
JAN 5 1976

MISS. BD. OF WATER COMMISSIONERS

If well telescopes please sketch and show depths.

GROUND LEVEL

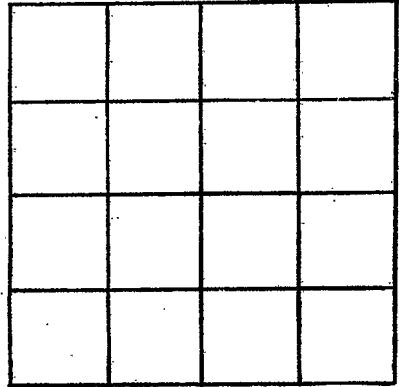

SECTION _____

Please indicate well location X.

ADDITIONAL INFORMATION

If more than one screen, show locations of each on sketch.