

Need Address & nearest town.

STONE
A 3002
5-5-76

MISSISSIPPI
BOARD OF WATER COMMISSIONERS
416 North State Street
Jackson, Mississippi 39201

WATER WELL DRILLERS LOG

5-5-76 date well completed 1976 firm name *Amel Candless* county well located *Stone*

LANDOWNER:	description of formations encountered	from	to
<i>Hermin Davis</i>			
(mailing address)	<i>Sandy Clay</i>	<i>4</i>	<i>38</i>
WELL LOCATION:	<i>Clay</i>	<i>38</i>	<i>78</i>
sec <i>2</i> T <i>2</i> S R <i>13</i> W	<i>Coarse Sand</i>	<i>78</i>	<i>85</i>
(distance) miles of (direction) of (nearest town)			

WELL PURPOSE: *HOME*
(home, irrigation, municipal, industrial)

- WELL COMPLETION DATA:
- (1) diameter (inches) *2 1/4*
 - (2) total depth (feet) *85*
 - (3) static water level (feet) *50* below above top of ground
 - (4) casing (material), (depth) *Plastic, 80'*
 - (size) if telescope see back.
 - (5) screen *5'*, *80'*
(length), (depth to top)
 - (size), (material) *2"*, *Plastic*
 - (6) pump *1*, *9*
(HP), (yield gpm)
 - (type power) *Elect*
 - (7) electric log *no*
(yes or no)


(organization running log)
(8) how well bottom plugged *Capped*

DRILLERS REMARKS:

MISSISSIPPI
BOARD OF WATER COMMISSIONERS
JUL 2 1976
MISS. Bd. of Water Comm.

If well telescopes please sketch and show depths.

GROUND LEVEL

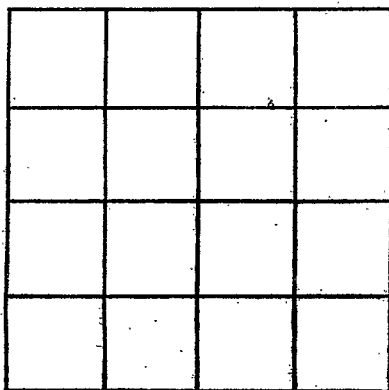

SECTION _____

Please indicate well location X.

ADDITIONAL INFORMATION

Lined area for additional information, consisting of 20 horizontal lines.

If more than one screen, show locations of each on sketch.