

Stone
 A 200
 2-22-77

MISSISSIPPI
 BOARD OF WATER COMMISSIONERS
 416 North State Street
 Jackson, Mississippi 39201

WATER WELL DRILLERS LOG

2-22 1977 *Arnold Anderson* Stone
 date well completed firm name county well located


LANDOWNER:	description of formations encountered	from	to
<i>Brent Stinger</i>	<i>Top Soil</i>	<i>0</i>	<i>3</i>
(mailing address)	<i>Samley Clay</i>	<i>3</i>	<i>17</i>
WELL LOCATION:	<i>B live clay</i>	<i>17</i>	<i>154</i>
sec. <i>8</i> T <i>36</i> S R <i>13</i> W	<i>Chance Sand</i>	<i>154</i>	<i>185</i>
<i>7</i> miles <i>SW</i> of <i>Wiggins</i>			
(distance) (direction) of (nearest town)			
WELL PURPOSE: <i>HOME</i>			
(home, irrigation, municipal, industrial)			
WELL COMPLETION DATA:			
(1) diameter (inches) <i>2"</i>			
(2) total depth (feet) <i>185'</i>			
(3) static water level (feet) <i>41'</i> below above top of ground			
(4) casing <i>Plastic</i> <i>180'</i>			
(material) (depth)			
(size) If telescope see back.			
(5) screen <i>5'</i> <i>180'</i>			
(length) (depth to top)			
<i>2"</i> <i>Plastic</i>			
(size) (material)			
(6) pump <i>1</i> <i>10</i>			
(HP) (yield gpm)			
<i>Elect</i>			
(type power)			
(7) electric log <i>No</i>			
(yes or no)			
(organization running log)			
(8) how well bottom plugged <i>Back with valve</i>			
DRILLERS REMARKS:			

RECEIVED
 MAR 9 1977

MISS. BD. OF WATER COMM

If well telescopes please sketch and show depths.

GROUND LEVEL

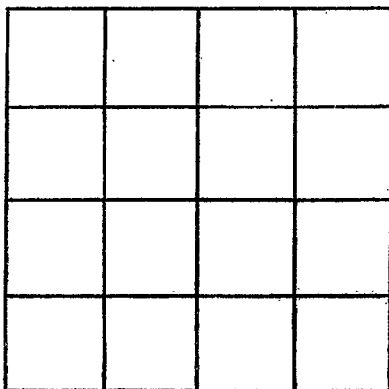

SECTION _____

Please indicate well location X.

ADDITIONAL INFORMATION

If more than one screen, show locations of each on sketch.