

Stone  
A 2005  
4-6-77

MISSISSIPPI  
BOARD OF WATER COMMISSIONERS  
416 North State Street  
Jackson, Mississippi 39201


WATER WELL DRILLERS LOG

4-6-77 <sup>13a</sup> *Parrell Anderson* Stone  
date well completed firm name county well located

| LANDOWNER:  | description of formations encountered | from | to |
|---|---------------------------------------|------|----|
| <i>Alex Smith</i>   | <i>Topsoil</i>                        | 0    | 3  |
| (mailing address)   | <i>Sandy Clay</i>                     | 3    | 18 |
| WELL LOCATION:<br>sec <i>30</i> T <i>2</i> S R <i>13</i> W<br><i>12</i> miles <i>W</i> of <i>Wiggins</i><br>(distance) (direction) (nearest town) | <i>Thin Sand</i>                      | 18   | 57 |
| WELL PURPOSE: <i>HOME</i><br>(home, irrigation, municipal, industrial)  | <i>Coarse Sand</i>                    | 57   | 65 |
| WELL COMPLETION DATA:   |                                       |      |    |
| (1) diameter (inches) <i>2"</i>   |                                       |      |    |
| (2) total depth (feet) <i>65'</i>   |                                       |      |    |
| (3) static water level (feet) <i>44'</i> below top of ground  |                                       |      |    |
| (4) casing <i>Plastic</i> , <i>60'</i><br>(material) (depth)  |                                       |      |    |
| _____ If telescope see back.<br>(size)  |                                       |      |    |
| (5) screen <i>5'</i> , <i>60'</i><br>(length) (depth to top)  |                                       |      |    |
| <i>2"</i> , <i>Plastic</i><br>(size) (material)   |                                       |      |    |
| (6) pump <i>1</i> (HP) <i>8</i> (yield gpm)   |                                       |      |    |
| <i>Elect</i><br>(type power)  |                                       |      |    |
| (7) electric log <i>NO</i><br>(yes or no)   |                                       |      |    |
| _____ (organization running log)  |                                       |      |    |
| (8) how well bottom plugged <i>Capped</i>   |                                       |      |    |
| DRILLERS REMARKS:   |                                       |      |    |

If well telescopes please sketch and show depths.

GROUND LEVEL

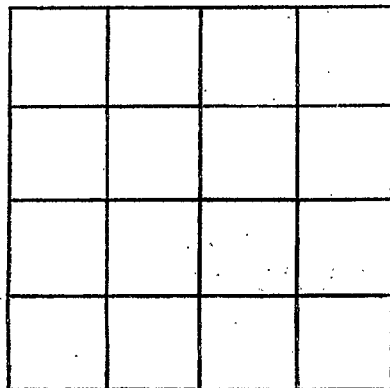

SECTION \_\_\_\_\_

Please indicate well location X.

ADDITIONAL INFORMATION

If more than one screen, show locations of each on sketch.