

Stone  
 A 2000  
 3/6/78

MISSISSIPPI  
 BOARD OF WATER COMMISSIONERS  
 416 North State Street  
 Jackson, Mississippi 39201


WATER WELL DRILLERS LOG

3-6 1978 Parnell Anderson Stone  
 date well completed firm name county well located

LANDOWNER:	description of formations encountered	from	to
Laron Seals			
(mailing address)	Sand	2	28
WELL LOCATION:	Blue Clay	28	186
sec. 25 T 2 N R 13 E S W	Hard Sand	186	213
8 miles W of Wiggins	Coarse Sand	213	233
(distance) (direction) (nearest town)			
WELL PURPOSE: HOME			
(home, irrigation, municipal, industrial)			
WELL COMPLETION DATA:			
(1) diameter (inches) 2"			
(2) total depth (feet) 233'			
(3) static water level (feet) 96' below top of ground			
(4) casing Plastic 228'			
(material) (depth)			
(size) if telescope see back.			
(5) screen 5' 228'			
(length) (depth to top)			
2" Plastic			
(size) (material)			
(6) pump 1 6			
(HP) (yield gpm)			
E coat			
(type power)			
(7) electric log no			
(yes or no)			
(organization running log)			
(8) how well bottom plugged			
Back with gravel			
DRILLERS REMARKS:			

If well telescopes please sketch and show depths.

GROUND LEVEL

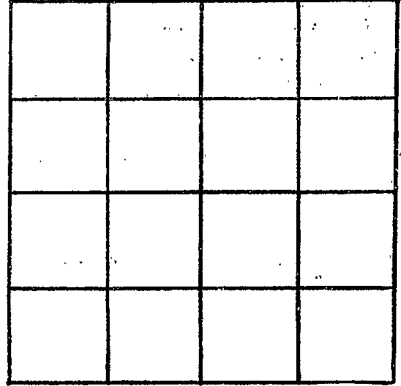

SECTION \_\_\_\_\_

Please indicate well location X.

ADDITIONAL INFORMATION

If more than one screen,  
show locations of each on sketch.