

Stone
A 2007
3/18/78

MISSISSIPPI
BOARD OF WATER COMMISSIONERS
416 North State Street
Jackson, Mississippi 39201

WATER WELL DRILLERS LOG

3-10 1978 Pamell Anderson Stone
date well completed firm name county well located


LANDOWNER:	description of formations encountered	from	to
<u>James Dedaux</u>	<u>Top Soil</u>	0	3
(mailing address)	<u>Sandy Clay</u>	3	16
WELL LOCATION:	<u>Fine Sand</u>	16	38
sec. <u>34</u> T. <u>2</u> N. R. <u>13</u> E.	<u>Clay</u>	38	48
S. W. of <u>Wileyville</u>	<u>Coarse Sand</u>	48	60
10 miles (distance) W (direction) of (nearest town)			
WELL PURPOSE: <u>Normal</u> (home, irrigation, municipal, industrial)			
WELL COMPLETION DATA:			
(1) diameter (inches) <u>2"</u>			
(2) total depth (feet) <u>60'</u>			
(3) static water level (feet) <u>28'</u> below top of ground.			
(4) casing <u>Plastic 5.5'</u> (material) (depth)			
_____ (size) if telescope see back.			
(5) screen <u>5.5"</u> <u>5.5'</u> (length) (depth to top)			
<u>2"</u> <u>Plastic</u> (size) (material)			
(6) pump <u>1</u> <u>10</u> (HP) (yield gpm)			
<u>Elect</u> (type power)			
(7) electric log <u>no</u> (yes or no)			
_____ (organization running log)			
(8) how well bottom plugged <u>Capped</u>			
DRILLERS REMARKS:			

RECEIVED
APR - 7 1978

MISS. BD. OF WATER COMM.

If well telescopes please sketch and show depths.

GROUND LEVEL

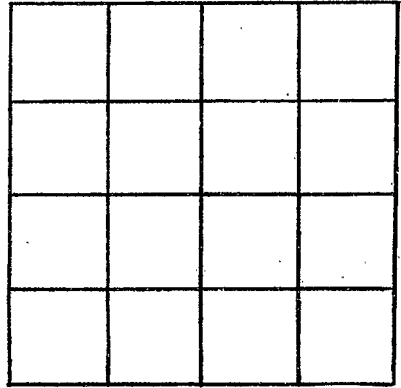

SECTION _____

Please indicate well location X.

ADDITIONAL INFORMATION

If more than one screen, show locations of each on sketch.