

Stone
 A 2008
 3/13/78

MISSISSIPPI
 BOARD OF WATER COMMISSIONERS
 416 North State Street
 Jackson, Mississippi 39201

WATER WELL DRILLERS LOG

3-13 1978 *Parsal Lee Anderson Stone*
 date well completed firm name county well located

LANDOWNER:	description of formations encountered	from	to
<i>Parsal Lee</i>			
(mailing address)	<i>Sandy Clay</i>	<i>2</i>	<i>15</i>
WELL LOCATION:	<i>Thin Sand</i>	<i>15</i>	<i>40</i>
sec. <i>34</i> T. <i>2</i> N. R. <i>13</i> E. S. <i>5</i> W. <i>5</i>			
<i>10</i> miles <i>W</i> of <i>Weyburn</i> (distance) (direction) (nearest town)			
WELL PURPOSE: <i>HOME</i> (home, irrigation, municipal, industrial)			
WELL COMPLETION DATA:			
(1) diameter (inches) <i>2"</i>			
(2) total depth (feet) <i>40'</i>			
(3) static water level (feet) <i>27</i> below top of ground.			
(4) casing <i>Plastic 35'</i> (material) (depth)			
(size) if telescope see back.			
(5) screen <i>5'</i> <i>33'</i> (length) (depth to top)			
<i>2"</i> <i>Plastic</i> (size) (material)			
(6) pump <i>1</i> <i>8</i> (HP) (yield gpm)			
<i>Elect</i> (type power)			
(7) electric log <i>no</i> (yes or no)			
(organization running log)			
(8) how well bottom plugged <i>Capped</i>			
DRILLERS REMARKS:			


RECEIVED

APR - 7 1978

MISS. BD. OF WATER COMM.

If well telescopes please sketch and show depths.

GROUND LEVEL

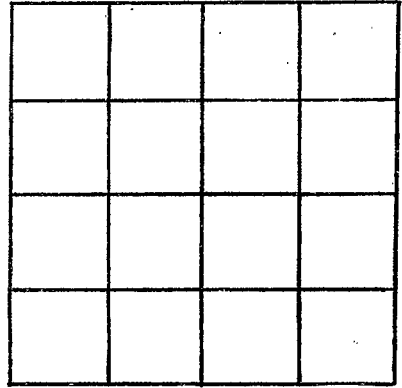

SECTION _____

Please indicate well location X.

ADDITIONAL INFORMATION

If more than one screen,
show locations of each on sketch.