

STONE
 A 2057
 4-12-78

MISSISSIPPI
 BOARD OF WATER COMMISSIONERS
 416 North State Street
 Jackson, Mississippi 39201

WATER WELL DRILLERS LOG

4-12 1978 *Shumell Machine* Stone
 date well completed firm name county well located

LANDOWNER:
Clifton Brown
 (mailing address)

description of formations encountered	from	to
<i>Top Soil</i>	<i>0</i>	<i>2</i>
<i>Sticky Clay</i>	<i>2</i>	<i>28</i>
<i>Course Sand</i>	<i>28</i>	<i>74</i>

WELL LOCATION:
 sec. *30* T. *2* N. R. *13* W.
12 miles *W* of *Wloghins*
 (distance) (direction) (nearest town)

WELL PURPOSE: *HOME*
 (home, irrigation, municipal, industrial)

WELL COMPLETION DATA:

(1) diameter (inches) *2"*

(2) total depth (feet) *74*

(3) static water level (feet) *38* below above top of ground.

(4) casing *Plastic*, *69'*
 (material) (depth)

_____ if telescope see back.
 (size)

(5) screen *55'*, *69'*
 (length) (depth to top)

2", *Plastic*
 (size) (material)

(6) pump *1*, *9*
 (HP) (yield gpm)

Elect
 (type power)

(7) electric log *nd*
 (yes or no)

_____ (organization running log)

(8) how well bottom plugged *Capped*


DRILLERS REMARKS:

RECEIVED
 MAY 8 - 1978

MISS. BD. OF WATER COMMISSIONERS

If well telescopes please sketch and show depths.

GROUND LEVEL

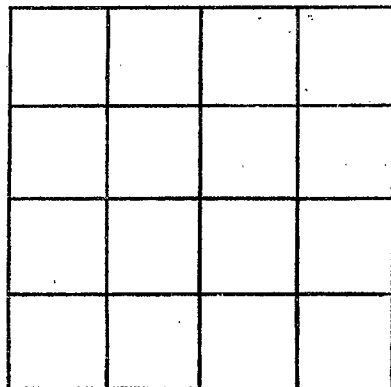

SECTION _____

Please indicate well location X.

ADDITIONAL INFORMATION

If more than one screen, show locations of each on sketch.